

HUMPHREYS MISSISSIPPI BOARD OF WATER COMMISSIONERS

K 15  
2-65


WATER WELL DRILLERS LOG

**CODED**

Date: 2, 1965, Driller: David Berry County Yazoo  
(Name)

(1) Owner of Land	Description & Color of Materials Sand, Clay, Red Clay, Shell, etc.	Thick- ness Feet	Depth Feet
<u>Louise Meeklin</u> (Name)	<u>Surface</u>	<u>34</u>	<u>34</u>
<u>Louise Meeklin</u> (Address)	<u>Blue Clay</u>	<u>29.8</u>	<u>63.8</u>
(2) Location: <u>1/4</u> , <u>1/4</u> , Sec. <u>34 T13 R9</u>	<u>Blue Clay</u>	<u>29.10</u>	<u>93.6</u>
_____ miles _____ of _____ (distance) (direction) (Nearest Town)	<u>Sand &amp; pea gravel</u>	<u>31.6</u>	<u>125</u>
(3) Topography: _____ (Hilly) (Flat) (Level)	<u>gravel, too 146</u>	<u>21</u>	<u>146</u>
(4) Purpose of Well: _____ (Domestic Irrigation Municipal, Industrial, Other)	<u>Clay</u>	<u>10</u>	<u>156</u>
Information upon completion of well:	<u>Blue Clay</u>	<u>62.4</u>	<u>218.4</u>
(1) Diameter <u>4x2</u> inches.	<u>Blue clay</u>	<u>30.5</u>	<u>248.9</u>
(2) Total Depth <u>1120</u> feet.	<u>Shale (thin) sand</u>	<u>31.2</u>	<u>279.1</u>
(3) Water Level <u>7</u> feet below top of ground.	<u>Sand with shell</u>	<u>30.2</u>	<u>309.2</u>
(4) Cased to <u>1080</u> , Size <u>4x2</u>	<u>Shale (thin) sand</u>	<u>30.3</u>	<u>340.5</u>
(5) Screen: Size <u>2"</u> , Length <u>40 ft.</u>	<u>Shale (thin) sand</u>	<u>15.7</u>	<u>456.2</u>
(6) Were any formations sealed against pollution? _____ yes, _____ no.	<u>Sand</u>	<u>30.10</u>	<u>523.8</u>
If YES depth of formation _____	<u>Sand with shell</u>	<u>30.6</u>	<u>554.2</u>
Why _____	<u>Shale (brown) thin sand</u>	<u>23.4</u>	<u>577.6</u>
Drillers Remarks: _____	<u>Sand with small broken shell</u>	<u>20.5</u>	<u>597.1</u>
_____	<u>Sand with shell</u>	<u>21</u>	<u>618.1</u>
_____	<u>Shale with sand</u>	<u>21.8</u>	<u>640.7</u>
_____	<u>Sand with broken shell</u>	<u>20.8</u>	<u>661.3</u>
_____	<u>Sand broken shell</u>	<u>21.9</u>	<u>683</u>
_____	<u>Sand broken shell</u>	<u>20.10</u>	<u>703.10</u>
_____	<u>Shale with small rock</u>	<u>21.10</u>	<u>723.8</u>
_____	<u>Sandy shale</u>	<u>21.9</u>	<u>748.5</u>
_____	<u>Sandy shale</u>	<u>20.8</u>	<u>769.1</u>
_____	<u>Sandy shale</u>	<u>20.5</u>	<u>789.6</u>
_____	<u>Sandy shale &amp; rock</u>	<u>21.11</u>	<u>811.5</u>
_____	<u>Brown shale</u>	<u>20.8</u>	<u>832.1</u>
_____	<u>" "</u>	<u>21.11</u>	<u>854</u>
_____	<u>Shale</u>	<u>10.11</u>	<u>864.1</u>
_____	<u>Sandy shale</u>	<u>61.5</u>	<u>925.1</u>
_____	<u>Sand &amp; shale</u>	<u>20.1</u>	<u>945.10</u>
_____	<u>Sand thin shale</u>	<u>20.10</u>	<u>967.8</u>
_____	<u>Sandy shale</u>	<u>31.2</u>	<u>1000.0</u>
_____	<u>Sand</u>	<u>88.4</u>	<u>1120</u>

(Use Back Side)

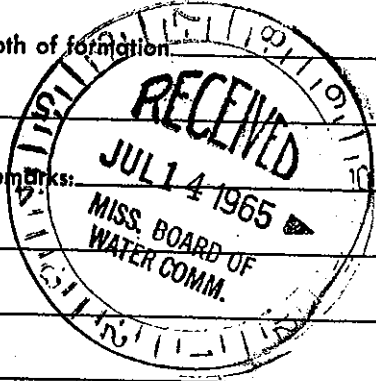

Mail this copy to Board of Water Commissioners 429 Miss. St. Jackson, Mis: