


Duplicate

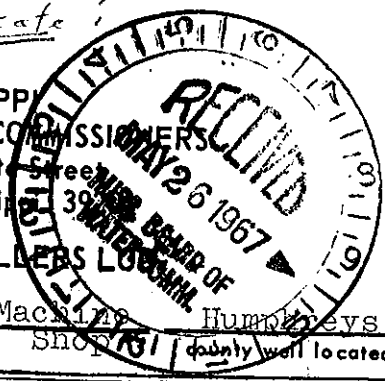

MISSISSIPPI BOARD OF WATER COMMISSIONERS  
416 North State Street  
Jackson, Mississippi 39201

WATER WELL DRILLERS LOG

Humphreys  
K 17  
5-67

5-2 1967 Rolling Fork Machine Shop Humphreys  
date well completed firm name county well located

LANDOWNER:	description of formations encountered	from	to
Eddie Davis			
Holly Bluff, Miss. (mailing address)	Loam	0	10
	Blue Clay	10	45
	Sand	45	80
	Sand & Gravel	80	108
<b>WELL LOCATION:</b>			
sec. 33 T. 13 N. R. 4 W.			
4 miles SSW of Louise (distance) (direction) (nearest town)			
<b>WELL PURPOSE:</b> Home (home, irrigation, municipal, industrial)			
<b>WELL COMPLETION DATA:</b>			
(1) diameter (inches) 2"			
(2) total depth (feet) 108'			
(3) static water level (feet) 14 below top of ground.			
(4) casing G. Pipe, 105' (material) (depth)			
2" (size) if telescope see back.			
(5) screen 3' 105' (length) (depth to top)			
2" Monell (size) (material)			
(6) pump _____ (HP) (yield gpm)			
(type power)			
(7) electric log No (yes or no)			
(organization running log)			
(8) how well bottom plugged Check valve			
<b>DRILLERS REMARKS:</b>			
Well pumped with air at about 10 G.P.M.			