

Humphreys

42 55 50
90 37 45

CODED

K 22

MISSISSIPPI BOARD OF WATER COMMISSIONERS

2-67

WATER WELL DRILLERS LOG

dryer well

Humphreys

Date: 2-1, 1967, Driller: Irrigation Serv County: DeSoto
(Name)

(1) Owner of Land: J.W. Stoner
(Name)
Louise, Miss
(Address)

(2) Location: S.W. 1/4, N.E. 1/4, Sec. 32, T13R4
7 miles S.W. of Louise
(distance) (direction) (Nearest Town)

(3) Topography: Flat
(Hilly) (Flat) (Level)

(4) Purpose of Well: Irrigation (Fish)
(Domestic) (Irrigation) (Municipal) (Industrial, Other)

Description & Color of Materials Sand, Clay, Red Clay, Shell, etc.	Thick- ness Feet	Depth Feet
0-13 Clay	13	13
13-23 clay	26	26
23-33 Clay	33	33
33-43 Fine Gray Sand	10	43
43-53 - - -	20	53
53-63 coarse sand & Pea Ro	10	63
63-73 coarse sand	10	73
73-83 - - -	20	83
83-93 - - -	30	93
93-103 coarse sand & gravel	10	103
103-113 - - -	20	113


Information upon completion of well:

- (1) Diameter 16 inches.
- (2) Total Depth 113 feet.
- (3) Water Level 18' feet below top of ground.
- (4) Cased to 73', Size 16"
- (5) Screen: Size 16", Length 40'
- (6) Were any formations sealed against pollution?
yes, X no.

If YES depth of formation _____

Why _____

Drillers Remarks: _____

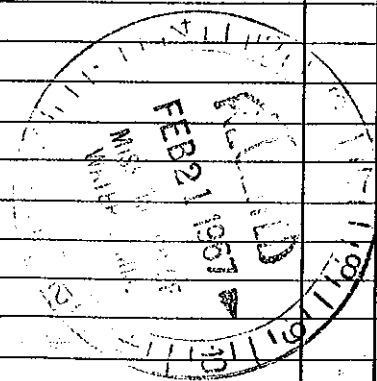

(Use Back Side)

Well No.

Mail this copy to Board of Water Commissioners 429 Miss. St. Jackson, Miss.