

MISSISSIPPI DEPARTMENT OF NATURAL RESOURCES

Bureau of Land and Water Resources

Southport Mall

P.O. Box 10631

Jackson, Mississippi 39209

CODED

WATER WELL DRILLERS LOG

Humphreys
K 36
12-12-80

12/12 1980
date well completed

Dyer
firm name

Humphreys
county well located

LANDOWNER:
BA SEWARD
Louise MS.
(mailing address)

WELL LOCATION:
sec 4 T 13 N R 4 E
2 miles NW of Louise
(distance) (direction) (nearest town)


WELL PURPOSES:
(home, irrigation, municipal, industrial)

WELL COMPLETION DATA

- (1) diameter (inches) 16"
- (2) total depth (feet) 111'
- (3) static water level (feet) 19' below top of ground.
- (4) casing Steel 111'
(material) (depth)
16" if telescope see back.
(size)
- (5) screen 40' 6"
(length) (depth to top)
16" Steel
(size) (material)
- (6) pump 60 3000
(HP) (yield gpm)
Diesel
(type power)
- (7) electric log (yes or no)
- (organization running log)
- (8) how well bottom plugged plate

description of formations encountered	depth	
	from	to
Clay	0	30
7' sand	30	35
Shale	35	48
Sand	48	111

CODED

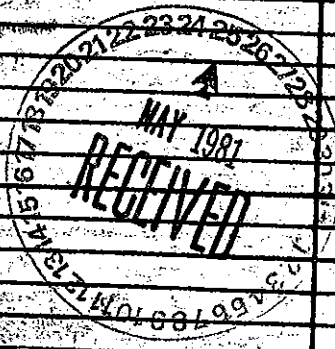

DRILLERS REMARKS: