
Blue Hors	E	
County: <u>finmphreys</u> Permit #: <u>Glo-475527</u> Driller: <u>J. NEWCOME</u> 0.773 Data dellina completed: 10:73, 12 Data dellina completed: 10:73, 12	ell Report riller's Log of Environmental Quality d Water Resources iox 2309 MS 39225 61- 5210 - 5228 (fax)	For Office Use Only:           Aquifer:
State Law requires that this report be prepared by the lice Department at the above address within 30 days of compl		the work and filed with the
Information on Well Owner (Landowner if borehole is not for a water well) Owner Name Blue Horse Farms	Well or Bo Latitude: <u>32° 59</u> , 11 Method of Lat/Long (circle or	orehole Location " Longitude: <u>10 ° 35 ' 39 "</u>
Varoo City     M5     39194       City     State     Zip Code	$\frac{NW}{SE} \times \frac{SE}{SE}$ Distance $\frac{SE}{NN}$ Direction $\frac{SE}{NN}$	$\frac{\text{Twn} / 3N}{\text{Rng} \partial \mathcal{Y} \mathcal{W}}$ Nearest Town of $\underline{\text{LOUKE}}$
Well / Boreh Date drilling started: 10.23.12 Date drilling completed: 10.23.1		
Location of the source of any surface water used for drilling: Method of dosing and volume of Chlorine used in drilling and develop Logs run (circle all applicable). No log run Electric Gamma Ray Name of organization running log(s): Purpose of borehole (check one): Water Well Geotechnical/Geolog Seismic Survey Other (describe) If drilling is not related to water well construction,	pment: <u>CALDRING</u> Density Sonic Neutron gical Investigation Ground	Other:
Purpose of Well (check one): Home Industrial Public Supply If a flowing well, method of flow regulation: Valve Oth Static Water Level: feet above or below (circle one) lan Method of Measurement (circle one) steel tape electric tape Well depth: 120 Well grouted to a depth of 10 feet Type o	ner (describe) nd surface Date measured: air line other:	
Casing length:	inches Type of casing: _inches Type of screen: feet to	P.V.C. P.V.C. feet hole Natural Development
Top of lap pipe or reduction in casing:feet. If teles	scoped or more than one scre	en, describe on next page
		Form: OLWR-SWR-1A (04/08)
		i i se se fili des
		FEB 2 0

1 1 1 1

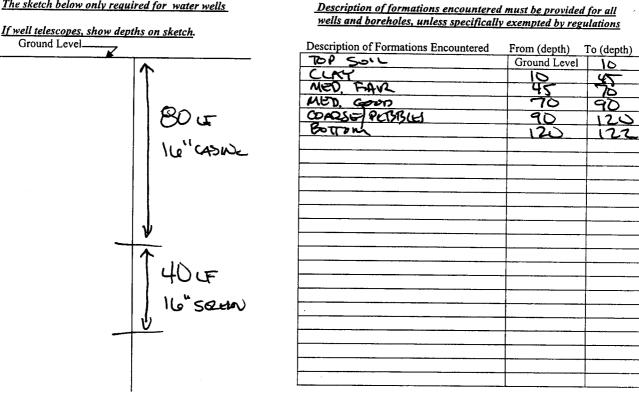

If more than one screen, show location of each on sketch

aid in l	ayout and include the following: 1) the well location; 2) any permanent structures on the property that may ocating the well; 3) any roads, power lines, or other items that may aid in locating the property and the well; rth arrow.
	SEE MAR
Landowner Name:	Form: OLWR-SWR-1A (04/08

I certify that the well/borehole was drilled, constructed, and completed in accordance with all applicable requirements of the Mississippi Department of Environmental Quality and the Mississippi Department of Health regulations, if applicable, and state laws.

Date

JOHN NEWLOME 0.773

10.23.2012

Print Name of Responsible Licensee and License No.


Signature of Licensee

$\frac{GW46456}{County: Hum/hfeys}$ Permit #: $\frac{100-43527}{13527}$ Driller: $I. Newcome 0.773$ Date completed: $10-23-12$	(601)354-6938 (fax)		ity Aquifer. 	ice Use Only: K193	
This report should be prepared by the pump installer in detail and filed with the Department within 30 days of the installation of pump.					
Well Owner Information		Well Location			
Owner Name: Blue horse F		Latitude: 32.59	-/- Longitude:	0.35-39	
Mailing Address: 9216 Hwy	149	Method of Lat/Long (o	ricle one): Convention	al Survey.	
		USGS quad, Hand-held GPS, Survey-grade GPS			
Yaroo (ity M	5 39194		Sec. 23 Two 131	N Rug OYW	
Čity State	Zip Code	Distance Dire	ction Nearest To	own	
Telephone No. ()		1 .	W. of Lanis		
			v		
Pump Type Circle one	an a	Ţ.	Power Type		
Air Lift Jet			Circle one		
	Submersible	Diesel Engine	Gasoline Engine	Natural Gas	
	Turbine	Electric Motor	Hand	Tractor PTO	
Centrifugal Rotary	Flowing Well	Windmill	Other (specify):	0	
Other (specify):		Horse Power Rating of Motor:			
Date Pump Installeci: 10-25-		Setting Depth:	70	feet	
Rated Pump Capacity: 2000	Gailons Per Minute	Number of Stages:			
Pump Test Data		Method of Measuring Water Level Circle one			
Date Well Toyled:		Alt Line Elec	tric Measuring Line	Steel Tape	
$\sqrt{2}$	Below Land Surface	Other upecify):		Such Tape	
Putping Water Level (B):	Below Land Surface	Chick Specify).	1,0		
Drawdown ((B - (A)):	Below Land Surface	For flowing well, mea	gured shut in head:	feet	
Test Pumping Rate:	Gallons Per Minute	Well yielded	GPM with a	drawdown of	
Duration of Pump Test (minimum 4 hours):	hours		t after		
				nours or humbing	
I HEREBY CERTIFY that the above staten Hubbard Stephens Print Name of Pump Installer and License I	7410	Thill	Pump Installer		
				FFN / U	



-3

6

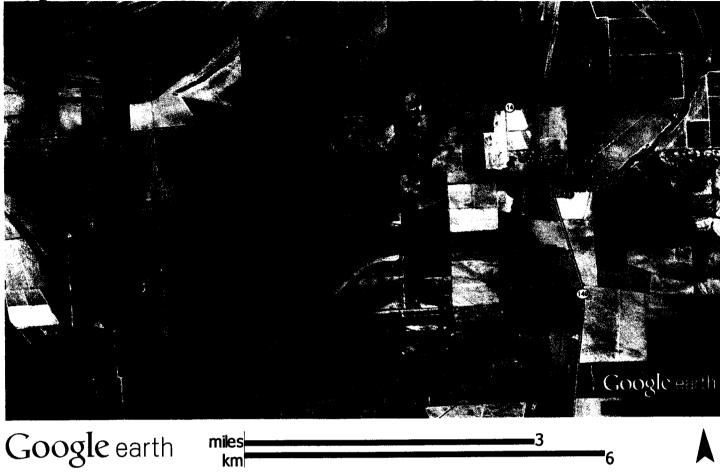

## Google earth

RECEIVED FEB 2 0 2013 BY: OUNR