

State Well Report

Part 1 - Driller's Log

Mississippi Department of Environmental Quality
 Office of Land and Water Resources
 P.O. Box 2309
 Jackson, MS 39225
 (601)961-5210
 (601)961-5228 (fax)

County: Humphreys
 Permit #: 66-4552701
 Driller: J. NEWCOMB 0:773
 Date drilling completed: 10.23.12

Per Office Use Only:
 Aquifer: _____
 Well #: K196
 L. S. Elevation: _____
 B-log #: FEB 19 2010

State Law requires that this report be prepared by the license holder responsible for the work and filed with the Mayor District Department at the above address within 30 days of completion of drilling of the well or borehole.

<p>Information on Well Owner (Landowner if borehole is not for a water well)</p> <p>Owner Name: <u>Blue Horse Farms</u> Mailing Address: <u>9216 Hwy 149</u> <u>Yazoo City MS 39194</u> City State Zip Code Telephone No. () _____</p>	<p>Well or Borehole Location</p> <p>Latitude: <u>32.59.11</u> Longitude: <u>90.35.39</u> <u>57.42</u> Method of Lat/Long (circle one): Conventional Survey, <u>09</u> USGS quad: <u>Hand-held GPS</u> Survey-grade GPS <u>NW 1/4 SW 1/4</u> Sec <u>23</u> Twn <u>13N</u> Rng <u>04W</u> Distance Direction Nearest Town <u>.5</u> Miles <u>N.W.</u> of <u>LOWME</u></p>
--	--

Well / Borehole Data

Date drilling started: 10.23.12 Date drilling completed: 10.23.12 Hole depth: 122 Hole diameter: 24"

Location of the source of any surface water used for drilling: Lake
 Method of dosing and volume of Chlorine used in drilling and development: CHLORINE TABLETS

Logs run (circle all applicable): No logs run Electric Gamma Ray Density Sonic Neutron Other: _____
 Name of organization running log(s): _____

Purpose of borehole (check one): Water Well Geotechnical/Geological Investigation _____ Ground Source Heat Pump _____
 Seismic Survey _____ Other (describe) _____
If drilling is not related to water well construction, skip the remainder of this block

Purpose of Well (check one): Home _____ Industrial _____ Public Supply _____ Irrigation Fish Culture _____ Other: _____

If a flowing well, method of flow regulation: Valve _____ Other (describe) _____

Static Water Level: _____ feet above or below (circle one) land surface Date measured: _____

Method of Measurement (circle one) steel tape electric tape air line other: _____

Well depth: 120 Well grouted to a depth of 10 feet Type of grout (circle one): Neat Cement Bentonite Mix
 Casing length: 80 feet Casing diameter: 16 inches Type of casing: P.V.C.
 Screen length: 40 feet Screen diameter: 16 inches Type of screen: P.V.C.
 Screen slot size: .050 inches Setting depth: From 80 feet to 120 feet

Type of completion (circle all applicable): Gravel packed Underreamed Telescoped Open hole Natural Development
 Other (describe): _____

Top of lap pipe or reduction in casing: _____ feet *If telescoped or more than one screen, describe on next page*


RECEIVED
 AUG 22 2013
 BY: OLWR

K196

The sketch below only required for water wells.

Description of formations encountered must be provided for all wells and boreholes, unless specifically exempted by regulations.

If well telescopes, show depths on sketch.

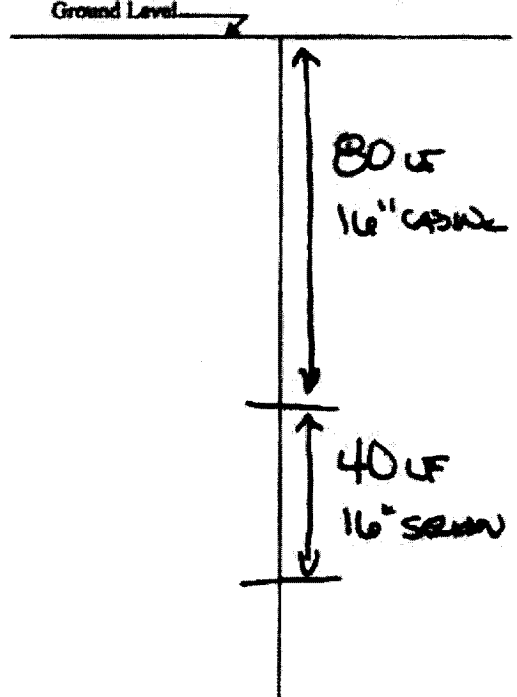

Description of Formations Encountered	From (depth)	To (depth)
TOP SOIL	Ground Level	10
CLAY	10	45
MED SAND	45	70
MED SAND	70	90
CONCRETE REBAR	90	120
BOTTOM	120	122

If more than one screen, show location of each on sketch

Sketch the property layout and include the following: 1) the well location; 2) any permanent structures on the property that may aid in locating the well; 3) any roads, power lines, or other items that may aid in locating the property and the well; 4) a north arrow.

RECEIVED
AUG 28 2012
BY: OLWR

SEE MAP

Landowner Name: _____

Form: OLWR-SWR-1A (04/08)

I certify that the well/borehole was drilled, constructed, and completed in accordance with all applicable requirements of the Mississippi Department of Environmental Quality and the Mississippi Department of Health regulations, if applicable, and state laws.

JOHN NEWCOMB 0-773 10-23-2012 [Signature]
 Print Name of Responsible Licensee and License No. Date Signature of Licensee

STATE WELL REPORT

Part 2

Pump Installer's Completion Report
Mississippi Department of Environmental Quality
Office of Land and Water Resources
P.O. Box 10631
Jackson, MS 39289-0631
(601)961-5210
(601)354-6938 (fax)

County: Humphreys
Permit #: 6W-43527
Driller: J. Newcome 0773
Date completed: 10-23-12

For Office Use Only:

Aquifer: _____
Well #: K196
Elevation: _____

This report should be prepared by the pump installer in detail and filed with the Department within 30 days of the installation of pump.

Well Owner Information	Well Location
Owner Name: <u>Blue Horse Farms</u>	Latitude: <u>32° 59' 41" N</u> Longitude: <u>90° 35' 39" W</u>
Mailing Address: <u>9216 Hwy 149</u>	Method of Lat/Long (circle one): <u>Conventional Survey</u>
<u>Yazoo City MS 39194</u>	USGS quad: <u>Hand-held GPS</u> Survey-grade GPS
City: _____ State: _____ Zip Code: _____	<u>NW 1/4 SW 1/4 Sec 23 Twp 13N Rng 04W</u>
Telephone No.: _____	Distance: _____ Direction: _____ Nearest Town: _____
	<u>0.5</u> Miles <u>N.W. of Louise</u>

Pump Type Circle one	Power Type Circle one
Air Lift: _____ Jet: _____ <u>Submersible</u>	Diesel Engine: _____ Gasoline Engine: _____ Natural Gas: _____
Bucket: _____ Piston: _____ Turbine: _____	<u>Electric Motor</u> : _____ Hand: _____ Tractor PTO: _____
Centrifugal: _____ Rotary: _____ Flowing Well: _____	Windmill: _____ Other (specify): _____
Other (specify): _____	Horse Power Rating of Motor: <u>50 HP</u>
Date Pump Installed: <u>10-25-12</u>	Setting Depth: <u>70</u> feet
Rated Pump Capacity: <u>2000</u> Gallons Per Minute	Number of Stages: <u>1</u>

Pump Test Data	Method of Measuring Water Level Circle one
Date Well Tested: _____	Air Lift: _____ Electric Measuring Line: _____ Steel Tape: _____
Static Water Level (A): <u>Not</u> Feet Below Land Surface	Other (specify): _____
Pumping Water Level (B): <u>Not</u> Feet Below Land Surface	For flowing well, measured flow in head: _____ feet
Drawdown (B) - (A): <u>Not</u> Feet Below Land Surface	Well yielded _____ GPM with a drawdown of _____ feet after _____ hours of pumping
Test Pumping Rate: _____ Gallons Per Minute	
Duration of Pump Test (minimum 4 hours): _____ hours	

I HEREBY CERTIFY that the above statements are true to the best of my knowledge.

Hubbard Stephens 741P Hubbard Stephens
Print Name of Pump Installer and License No. (if applicable) Signature of Pump Installer

RECEIVED
BIR: CULW



Google earth

miles
km



Faint, illegible handwritten text.