

**HUMPHREYS**

Date: 5-16-63 1963 Driller: BOB CRESSWELL County HUMPHREYS

5-16-63


(1) Owner of Land: HARRIS  
 (Name)  
WOLF LAKE (Address)  
 (2) Location: 35 13 N W  
3 R  
3  
2 miles (distance) W of Wolf Lake  
 (direction) (feet below town)  
 (3) Topography: LEVEL  
 (Hilly) (Flat) (Level)  
 (4) Purpose of Well: DOMESTIC  
 (Domestic Irrigation) (Municipal, Industrial, Other)

Description & Color of Materials Sand, Silt, etc.	Thickness Feet	Depth Feet
<b>CODED</b>		
SAND AND GRAVEL	160	160
BLUE CLAY	40	200
GREY TOP SHALE	40	240
GREY SHALE		
HARD	100	340
GREY SAND	60	400
GREY SAND AND SHALE	250	650
BROWN SHALE	150	800
SAND	83	883

Information upon completion of well:

(1) Diameter 4 1/2 inches. 168' 4" BLK  
 (2) Total Depth 883 feet.  
 (3) Water Level 15 feet below top of ground.  
 (4) Cased to 257, Size 2x4  
 (5) Screen: Size 2" .008, Length 30'  
 (6) Were any formations sealed against pollution?  
 \_\_\_\_\_ yes, \_\_\_\_\_ no.

**CODED**

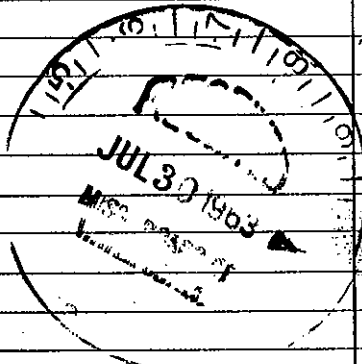

If YES depth of formation 105' 1/4 gabb.  
 Why 1 HP SUB. PUMP  
 Drillers Remarks: 220 GAL TH. A  
22 GAL. PER MIN.  
2 1/2" BUSHING - PLUG  
WE AT HARD LEAD SEAL

(Use Back Side)

Well No.

Mail this copy to Board of Water Commissioners 429 Miss. St. Jackson, Miss.