


HUMPHREYS  
L31  
1-7-66

MISSISSIPPI BOARD OF WATER COMMISSIONERS

HUMP.  
WATER WELL DRILLERS LOG

BUTANE GAS CO

**CODED**

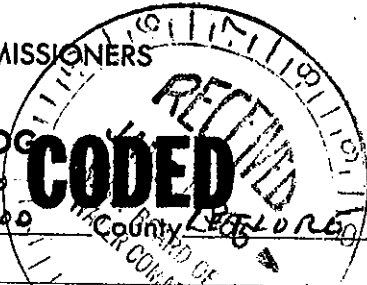

Date: 1/7, 1966, Driller: OF GREENWOOD  
(Name)

(1) Owner of Land: J.B. WILLIAMSON  
(Name)  
LOUISE, MISS  
(Address)

(2) Location: 1/4, 1/4, Sec. 35 T13R3  
11 miles EAST of LOUISE  
(distance) (direction) (Nearest Town)

(3) Topography: FLAT  
(Hilly) (Flat) (Level)

(4) Purpose of Well: DOMESTIC  
(Domestic Irrigation, Municipal, Industrial, Other)

Description & Color of Materials Sand, Clay, Red Clay, Shell, etc.	Thick- ness Feet	Depth Feet
0-16 CLAY	16	16
90 SAND + PEA GRAVEL	74	90
135 GRAVEL	45	135
190 SANDY SHALE	55	190
235 SAND	45	235
360 SHALE	125	360
362 ROCK	2	362
430 SHALE	68	430
482 SAND	52	482
728 SANDY SHALE	246	728
742 Gummy SHALE	14	742
800 SHALE + SAND ST	59	800
866 SAND (HARD)	66	866
889 SAND / SHALE	23	889
BOTTOM OF WELL 860 FT		
<b>CODED</b>		

Information upon completion of well:

(1) Diameter 4x2 inches.

(2) Total Depth 860 feet.

(3) Water Level 22 feet below top of ground.

(4) Cased to 126, Size 4"  
126-860, Size 2"

(5) Screen: Size 2", Length 20 FT

(6) Were any formations sealed against pollution?  
yes, X no.

If YES depth of formation \_\_\_\_\_

Why \_\_\_\_\_

Drillers Remarks: \_\_\_\_\_

Yield in G. P. M.: 18

Power: ELECTRIC

Crops irrigated & Acreage: NONE

(Use Back Side)

Well No.

Mail this copy to Board of Water Commissioners 429 Miss. St. Jackson, Miss.