

Humphreys
L44
2-67

22 56 40
90 27 30

CODED

MISSISSIPPI BOARD OF WATER COMMISSIONERS

WATER WELL DRILLERS LOG


Date: 2-4, 1967, Driller: Syer will Humphreys
Irrigation Serv County Leflore
(Name)

(1) Owner of Land: PAD FORD DU BOIS
(Name)
YAZOO City, Miss
(Address)
(2) Location: NW 1/4, SE 1/4, Sec 36 T12R3
8 miles NW of Y.C. Miss
(distance) (direction) (Nearest Town)
(3) Topography: FLAT
(Hilly) (Flat) (Level)
(4) Purpose of Well: IRRIGATION (Fish)
(Domestic Irrigation
Municipal, Industrial, Other)

Description & Color of Materials Sand, Clay, Red Clay, Shell, etc.	Thick- ness Feet	Depth Feet
<u>Clay</u>	<u>23</u>	<u>23</u>
<u>Fine Brown Sand</u>	<u>10</u>	<u>33</u>
<u>Coarse Brown Sand</u>	<u>10</u>	<u>43</u>
<u>Coarse Sand</u>	<u>30</u>	<u>73</u>
<u>Coarse Sand + Gravel</u>	<u>20</u>	<u>93</u>
	<u>10</u>	<u>103</u>

Information upon completion of well:

(1) Diameter 12 inches.
(2) Total Depth 103 feet.
(3) Water Level 21' feet below top of ground.
(4) Cased to 63', Size 12"
(5) Screen: Size 12", Length 40'
(6) Were any formations sealed against pollution?
yes, X no.
If YES depth of formation _____
Why _____
Drillers Remarks: _____

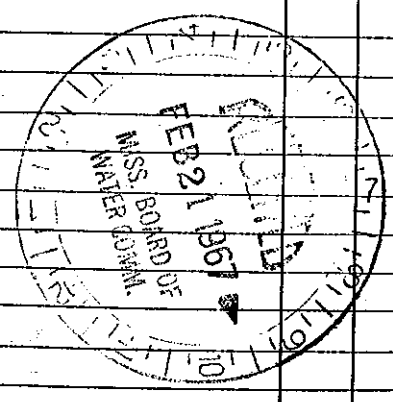

Well No.

(Use Back Side)

Retain this copy for your office files.