

SWAREK # 1

Humphreys

State Well Report

Part 1

Mississippi Department of Environmental Quality
Office of Land and Water Resources
P.O. Box 10631
Jackson, MS 39289-0631
(601)961-5210
(601)354-6938 (fax)

Part 2 never received 3/13

For Office Use Only:

Aquifer: _____
Well #: L 102
L. S. Elevation: _____
E-log #: _____

County: YAZOO
Permit #: GW-45244
Driller: J. NEWCOME 0.773
Date drilling completed: 5-6-2011

State Law requires that this report be prepared by the driller in detail and filed with the Department within 30 days of completion of drilling of the well.

Well Owner Information	Well Location
Owner Name: <u>World Ag Inc. / Swarek</u>	Latitude: <u>32.58.53</u> Longitude: <u>90.27.34</u>
Mailing Address: <u>1261 Pass Rd</u>	Method of Lat/Long (circle one): <u>52</u> Conventional Survey, <u>36</u>
<u>Gulfport MS 39051</u>	USGS quad: <u>Hand-held GPS</u> Survey-grade GPS
City State Zip Code	<u>NE 1/4 Sec 13 OK</u> Twn <u>13N</u> Rng <u>03W</u>
Telephone No. () _____	Distance Direction Nearest Town <u>8</u> Miles <u>S</u> of <u>SIWER CITY</u>

Well Data

Purpose of Well (circle one) Home Industrial Public Supply Irrigation Fish Culture Other: _____

Date well drilling started: 5-6-2011 Date well drilling completed: 5-6-2011

If flowing, method of flow regulation: Valve _____ Other (describe) _____

Static Water Level: _____ feet above or below (circle one) land surface Date measured: _____

Method of Measurement (circle one) steel tape electric tape air line other: _____

Hole depth: 122 Well depth: 120 Well grouted to a depth of 10 feet

Type of grout (circle one): Cement Bentonite Mix

Casing length: 80 feet Casing diameter: 16 inches Type of casing: P.V.C.

Screen length: 40 feet Screen diameter: 16 inches Type of screen: P.V.C.

Screen slot size: .050 inches Setting depth: From 80 feet to 120 feet

Type of completion (circle all applicable) Gravel packed Underreamed Telescoped Open hole Natural Development

Other (describe): _____

Top of lap pipe or reduction in casing: _____ feet. If telescoped or more than one screen, describe on back of page

Logs run (circle all applicable) No log run Electric Gamma Ray Density Sonic Neutron Other: _____

Name of organization running log(s): _____

I certify that the well was drilled, constructed, and completed in accordance with all applicable requirements of the Mississippi Department of Environmental Quality and/or the Mississippi Department of Health regulations and state laws.

Department of Environmental Quality and/or the Mississippi Department of Health regulations and state laws.

JOHN NEWCOME 0.773


[Signature]

Print Name of Water Well Contractor and License No.

Signature of Water Well Contractor

No pump installed yet due to high water/flooding

RECEIVED
JUN 03 2011
BY: OLIVER

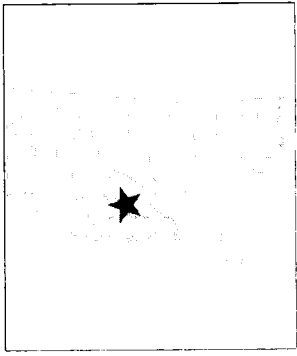

Legend

- [] County Boundaries
- [] MS One Call Natchez Trace Parkway
- [] MS One Call Interstate Highway
- [] MS One Call US / State Highway
- [] MS One Call 3 digit State Highway
- [] MS One Call County Roads and Streets
- [] Incorporated Cities
- [] Other Urban (non-incorporated)
- [] NHD Other Areas (dbl streams and Inun)

adams07_m.sid
alcorn07_m.sid
amite07_m.sid
attala07_m.sid
benton07
bolivar07_m.sid
calhoun07_m.sid
carroll07_m.sid
chickasaw07_m.sid
choctaw07_m.sid
clarborne07_m.sid
clarke07_m.sid
clay07_m.sid
coahoma07_m.sid

Scale: 1:21,281

This map is a user generated static output from an Internet mapping site and is for general reference only. Data layers that appear on this map may or may not be accurate, current, or otherwise reliable. THIS MAP IS NOT TO BE USED FOR NAVIGATION.