County:	Humphre	ys ,
Permit #:	GW-4635	<sub>58</sub> /
Driller:	Irrigation	Equipment
Date drilli	ng completed:	07/06/2012

## **State Well Report** Part 1 - Driller's Log

Mississippi Department of Environmental Quality Office of Land and Water Resources P.O. Box 2309 Jackson, MS 39225

(601) 961-5210 (601) 961-5228 (fax)

F	or Office Use Only:	
Aquifer:	L104	
Well #:		
L.S. Elevation:		
E-log #:		

State Law requires that this report be prepared by the license holder responsible for the work and filed with the

Department at the above address w	ithin 30 days of completion of drilling of the well or borehole.
Information on Well Owner	Well or Borehole Location
(Landowner if borehole is not for a water	well)
Owner Name Byron Seward	Latitude: 32 ° 59 ' 05 " Longitude: 90 ° 32 ' 57 "
Mailing Address: P.O. Box 266	Method of Lat/Long (check one):   Conventional Survey,
	☐ USGS quad, ☐ Hand-held GPS, ☐ Survey-grade GPS
	39097 SE ¼ SW ¼ Sec 7 ✓ Twn 13N ✓ Rng 3W ✓
City State	Zip code NW Distance Direction Nearest Town
Telephone No(	Miles East of _Louise
	Well / Borehole Data
Date drilling started: 07/06/2012 Date drilling co	mpleted: <u>07/06/2012</u> Hole depth: <u>125</u> Hole diameter: <u>24"</u>
Location of the source of any surface water used for drilling Method of dosing and volume of Chlorine used in drilling	
	ric Gamma Ray Density Sonic Neutron Other:
Purpose of borehole (check one):   Water Well	Geotechnical/Geological Investigation Ground Source Heat Pump
Seismic Survey	Other (describe)
	water well construction, skip the remainder of this block
	☐ Public Supply ☐ Irrigation ☐ Fish Culture ☐ Other:
If flowing, method of flow regulation: Valve	Other (describe)
	eck one) □ land ⊠ surface Date measured: 07/07/2012
Method of Measurement (check one) ⊠ steel tape □ o	electric tape 🔲 air line 🔲 other:
Well depth: 125 Well grouted to a depth of 1	feet Type of grout (check one): ☐ Neat Cement ☒ Bentonite ☐ Mix
Casing length: <u>85</u> feet Casing diameter	r: 16 inches Type of casing: PVC
Screen length: 40 feet Screen diameter	: 16 inches Type of screen: PVC
Screen slot size:050 inches Setting	depth: From 86 feet to 125 feet
Type of completion (check all applicable):   Gravel p	acked Underreamed Telescoped Open hole Natural Development
Other (de	escribe):
Top of lap pipe or reduction in casing:	feet. If telescoped or more than one screen, describe on next page

Form: OLWR-SWR-1A (04/08)

RECEIVED

JUL 12 1012

## The sketch below only required for water wells

If well telescopes.	show	depths	on	sketch.	

<u>If well telescopes,</u>	show	<u>depths</u>	on	<u>sketch.</u>
Ground leve	el			

Description of forma	ations encountered	must be provided	i for all
wells and boreholes.			

Description of Formations Encountered	From (depth)	To (depth)
Clay	Ground level	15
Fine Sand	16	25
Medium Sand	26	35
Course Sand	36	65
Course Sand & Gravel	66	125

If more than one screen, show location of each on sketch

aid i	layout and include the foll n locating the well; 3) any north arrow.	owing: 1) the well location roads, power lines, or other	n; 2) any permanent structures or er items that may aid in locating	on the property that may the property and the well;
Landowner Name:	Byron Seward			
I certify that the well/b Mississippi Departmen laws.	orehole was drilled, constru t of Environmental Quality	cted, and completed in acco and the Mississippi Depart	ordance with all applicable requir ment of Health regulations, if app	Form: OLWR-SWR-1A (04/08) ements of the blicable, and state
	695	07/17/2012	Yak	
r ime transc of responsible Pi	censee and License 170.	Date	Signature of Licensee	RECEIVED
				JU 13 2012

## STATE WELL REPORT

## Part 2 **Pump Installer's Completion Report**

Mississippi Department of Environmental Quality Office of Land and Water Resources P.O. Box 2309 Jackson, MS 39225 (601) 961-5210 (601) 961-5228 (fax)


For Office Use Only:					
Aquifer:		_			
Well #:		_			
Elevation:		_			

Driller: Irrigation Equipment Date drilling completed: 07/06/2012 Copy information from block on Part 1

County: Humphreys Permit #: GW-46358

Well	Owner Information			Well Location	
Owner Name: Byron S	eward		Latitude: 32 59' 0:	5.6 N Longitude:	90 32' 57.8 W
Mailing Address: P.O. I	Box 266		Method of Lat/Long (	(check one):	entional Survey,
			USGS quad	, A Hand-held GPS,	☐ Survey-grade GPS
Louise	e Ms	39097	SE ¼ SW	½ Sec 7 T	13N R 3W
City	State	Zip code	Distance	<del></del>	est Town
Telephone No. (	· -			East of Loui	
	Pump Type Check one			Power Type Check one	
Air Lift	] Jet	Submersible	Diesel Engine	Gasoline Engine	Natural Gas
Bucket	Piston 🖂	Turbine	Electric Motor	Hand	Tractor PTO
Centrifugal	Rotary	Flowing Well	Windmill	Other (specify):	-
Other (specify):			Horse Power Rating of	of Motor: 40	
Date Pump Installed: 07/	07/2012		Setting Depth: 70		feet
Rated Pump Capacity 16	<b>00+/-</b>	Gallons Per Minute	Number of Stages:	2	
	Pump Test Data		Met	hod of Measuring Wat	ter Level
Date Well Tested:			Air Line	☐ Electric Measuring Lin	ne Steel Tape
Static Water Level (A):			Other (specify):		_ •
Pumping Water Level (B):	Feet B	elow Land Surface			
Drawdown [(B) - (A)]: _	Feet B	elow Land Surface	For flowing well, mea	sured shut in head:	feet
Test Pumping Rate:	Ga	llons Per Minute	Well yielded		GPM with a drawdown of
Duration of Pump Test (mi	nimum 4 hours):	hours	fo	eet after	hours of pumping
This is for (check one	): New Well	Replacen	nent of Existing Pump	Repair of Existing	Pump
I HEREBY CERTIFY that	the above statements are	true to the best of m	y knowledge)		
Patrick Chism		0695	tal		DECEMEN
	aller and License No. (if a		Signature of F	Pump Installer	Form: 01WR;SWR-(0 107-09)

2/04

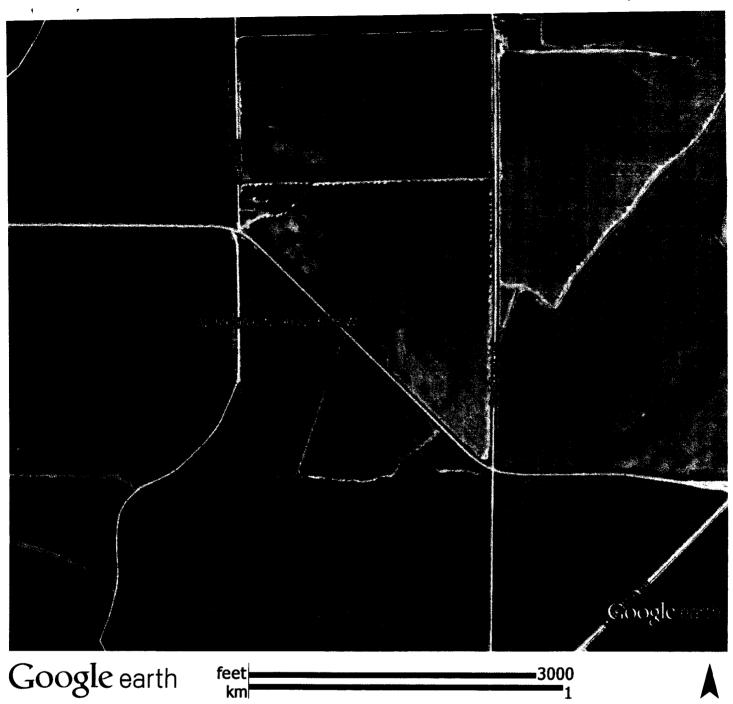

**RECEIVED** 

JUL 1 9 2012

BY: OWR