

ISSAQUONA MISSISSIPPI BOARD OF WATER COMMISSIONERS

A 31

10-28-61

WATER WELL DRILLERS LOG

5-?
CODED

Date: 10/28, 1961, Drilled by Bailey Drilling Co County Washington
(Name)

(1) Owner of Land W. P. Touchberry
(Name)
Glen Allan
(Address)
(2) Location: 1/4, 1/4, Sec. 18 T13 R8
5 miles South of Glen Allan
(distance) (direction) (Nearest Town)
(3) Topography: Flat
(Hilly) (Flat) (Level)
(4) Purpose of Well: Domestic
(Domestic Irrigation, Municipal, Industrial, Other)


Description & Color of Materials Sand, Clay, Red Clay, Shell, etc.	Thick- ness Feet	Depth Feet
Sand	5	5
Clay	15	20
Sand	60	80
Gravel + Sand	18	98
Mud	168	266
Sand	61	327
Mud	13	340
Sand	49	389
Mud	16	405
Sand + Mud	375	780
Sand	80	860

Information upon completion of well:

(1) Diameter 4x2 1/2 x 2 inches.
(2) Total Depth 850 feet.
(3) Water level 16 feet below top of ground.
(4) Cased all way, Size 4x2 1/2 x 2
(5) Screen: Size 2, Length 30 ft.
(6) Were any formations sealed against pollution?
yes, X no.

6" Rock at 478
4" " " 618
6" " " 670

CODED

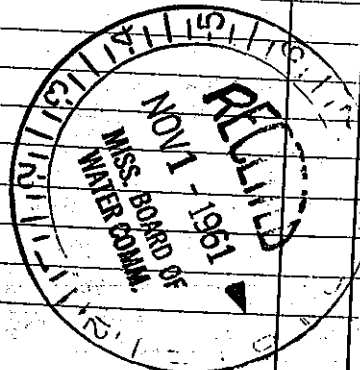

(Use Back Side)

Mail this copy to Board of Water Commissioners 429 Miss. St. Jackson, N.