

ISSAQUONA

MISSISSIPPI BOARD OF WATER COMMISSIONERS

A 33

4-17-62

WATER WELL DRILLERS LOG

16
CODED

Date: 4/17, 1962, Driller: Pailey Drilling Co. County: Washington
(Name)

(1) Owner of Land: C. F. Jennings
(Name)
Rolling Fork,
(Address)

(2) Location: 1/4, 1/4, Sec. 21 T13R8
5 miles S of Sten Allen
(distance) (direction) (Nearest Town)

(3) Topography: Flat
(Hilly) (Flat) (Level)

(4) Purpose of Well: Domestic
(Domestic Irrigation
Municipal, Industrial, Other)

Description & Color of Materials Sand, Clay, Red Clay, Shell, etc.	Thick- ness Feet	Depth Feet
Clay	18	18
Sand	27	45
Gravel	55	100
Mud	200	300
Sand	50	350
Mud	10	360
Sand	94	454
Mud + Sand	509	963
Rock every 15 or 20 ft from 454 to 963		
Sand	63	1026

Information upon completion of well:

(1) Diameter 3x2 inches.

(2) Total Depth 1026 feet.

(3) Water Level 7 feet below top of ground.

(4) Cased to all way, Size 3x2.

(5) Screen: Size 2", Length 10 ft.


(6) Were any formations sealed against pollution?
 _____ yes, X no.

If YES depth of formation _____

Why _____

Drillers Remarks: _____

CODED

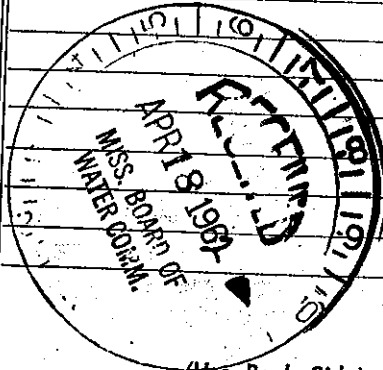

(Use Back Side)

Well No

Mail this copy to Board of Water Commissioners 429 Miss. St. Jackson, Miss