

MISSISSIPPI BOARD OF WATER COMMISSIONERS
 ISSAQUENA

A34
 7-1-63

WATER WELL DRILLERS LOG

Date: July 1, 19 63 Driller: RT Miner County: Jefferson
 (Name)

CODED


(1) Owner of Land:	Description & Color of Materials Sand, Clay, Red Clay, Shell, etc.	Thick- ness Feet	Depth Feet
Pat Warren (Name)	Sand & Gravel	0	-180
(Address)	Shale	180	-300
(2) Location: $\frac{3}{4}$, $\frac{1}{4}$, Sec. $\frac{18}{20}$ T13R7	Sand & Shale	300	-500
3 miles S of Grace (distance) (direction) (Nearest Town)	Sand, Shale & Rock Sand	500	-900
(3) Topography: <input checked="" type="checkbox"/> (Hilly) <input type="checkbox"/> (Flat) <input type="checkbox"/> (Level)			
(4) Purpose of Well: Domestic (Domestic Irrigation, Municipal, Industrial, Other)			

Information upon completion of well:

- (1) Diameter: 2" inches.
- (2) Total Depth: 980 feet.
- (3) Water Level: 8' feet below top of ground.
- (4) Cased to: 500', Size: 3"
- (5) Screen: Size: 2", Length: 30'
- (6) Were any formations sealed against pollution?
 yes, no.

If YES depth of formation: all-
 Why: keep out hard water

Drillers Remarks:

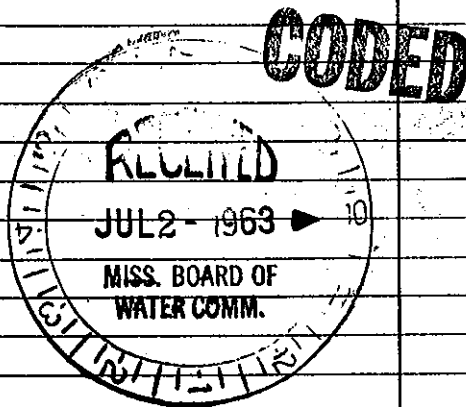

Well No.

(Use Back Side)

Mail this copy to Board of Water Commissioners 429 Miss. St. Jackson, Miss