

ISSAQUENA MISSISSIPPI BOARD OF WATER COMMISSIONERS

BA 35
5-64

WATER WELL DRILLERS LOG

CODED

Date: May, 1964, Driller: DAVID BERRY County
(Name)

(1) Owner of Land: S. M. Higgle
(Name)
Mayesville, Miss.
(Address)

(2) Location: 1/4, 1/4, Sec. 34 T13R8,
_____ miles _____ of _____
(distance) (direction) (Nearest Town)

(3) Topography: Flat
(Hilly) (Flat) (Level)

(4) Purpose of Well: Domestic
(Domestic Irrigation
Municipal, Industrial, Other)

Description & Color of Materials Sand, Clay, Red Clay, Shell, etc.	Thick- ness Feet	Depth Feet
Clay	35	35
fine sand	3	38
sand	32	70
Sand	20	90
gravel	25	115
band of layers of gravel	17.6	132.6
sand	2.4	135
sand	1	136
Hard clay	76	212
Sandy clay	74.2	286.2
Sand	143.8	430
Shale	37.1	467.1
Brown Shale	25.10	492.1
Shale	14.1	510
Sand	8	518
Clay	9.1	527.1
Clay	14.9	542
Rock	1	543
Clay	15.2	558.2
Brown Clay	16.10	625
Rock	1	626
Brown clay	37.3	663.3
Shale with clay. Hard	20.4	683.7
Shale	21.6	695.3
Sandy Shale	20.5	715.8
Shale	20.6	736.4
Sandy Shale	21.8	758
Sandy Shale	19.6	777.6
Sandy Shale	20.10	798.4
Shale	103.4	902.7
fine sand	20.1	1042.8
Sand fine	15.7	1062.5
Shale	22.2	1085.7

CODED

Information upon completion of well:

(1) Diameter 4 1/2 inches.

(2) Total Depth 1085.7 feet.

(3) Water Level 10 feet below top of ground. 134 ft. 4"

(4) Cased to 92 ft. 2 1/2" Size _____


(5) Screen: Size 2", Length 30

(6) Were any formations sealed against pollution?
_____ yes, _____ no.

If YES depth of formation _____

Why _____

Drillers Remarks: _____

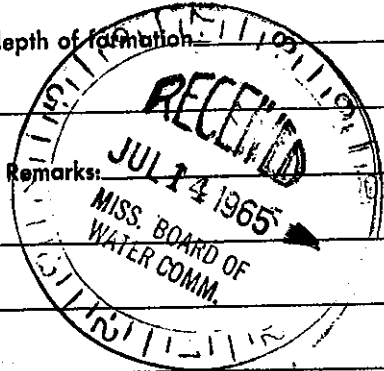

(Use Back Side)

Mail this copy to Board of Water Commissioners 429 Miss. St. Jackson, Miss.