

ISSAQUENA

A 41

1-21-74

MISSISSIPPI
BOARD OF WATER COMMISSIONERS
416 North State Street
Jackson, Mississippi 39201

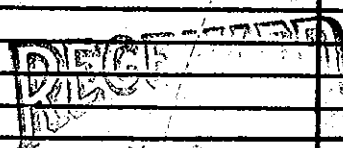
WATER WELL DRILLERS LOG

ISSAQUENA

1-21
date well completed

Schulte Drilling Co.
firm name

Issaquena
county well located

LANDOWNER: <u>?</u>	description of formations encountered	from	to
<u>Sub. Joe New + Hughes</u>			
<u>Oil Drilling Co</u> (mailing address)	<u>sand</u>	<u>36</u>	<u>105</u>
WELL LOCATION:			
sec. <u>20</u> T. <u>13</u> N. <u>8</u> E R. <u>8</u> E W	CODED		
(distance) _____ miles _____ of _____ (direction) _____ (nearest town)			
WELL PURPOSE: (home, irrigation, municipal, industrial)			
WELL COMPLETION DATA:			
(1) diameter (inches) <u>4"</u>			
(2) total depth (feet) <u>105</u>			
(3) static water level (feet) <u>12</u> below top of ground.			
(4) casing <u>P.V.C.</u> (material) _____ (depth) _____			
_____ (size) If telescope see back.			
(5) screen <u>10</u> (length) _____ (depth to top) _____			
<u>4"</u> <u>P.V.C.</u> (size) _____ (material) _____			
(6) pump <u>None</u> <u>?</u> (HP) _____ (yield gpm) _____			
(type power) _____			
(7) electric log <u>no</u> (yes or no)			
(organization running log) _____			
(8) how well bottom plugged <u>clay</u>			
DRILLERS REMARKS:			
 MAY - 2 - 1974 MISS. BD. OF WATER COMMISSIONERS			