

#1

Issaquena
A 44
6-67

MISSISSIPPI
BOARD OF WATER COMMISSIONERS
416 North State Street
Jackson, Mississippi 39201 CODED

WATER WELL DRILLERS LOG

June 28 1967 Five County Farmers Co Issaquena
date well completed firm name county well located

LANDOWNER: D. E. H. WINN

description of formations encountered	from	to
TOP SOIL Clay & Sand		14'
Clay	14	20 1/2
Clay & fine Sand	20 1/2	27
fine Sand	27	40
Clay	40	66
Sand & Pea rock	66	79
Sand & Gravel	79	113
Clay at	113	

Greenville Miss
(mailing address)


WELL LOCATION:
sec 20 T 13 N R 9 W
4 miles So of Greenville
(distance) (direction) (nearest town)

WELL PURPOSE: Irrigation
(home, irrigation, municipal, industrial)

WELL COMPLETION DATA:

- (1) diameter (inches) 6
- (2) total depth (feet) 113
- (3) static water level (feet) 17' below above top of ground.
- (4) casing 6" x 65'
(material) (depth)
6" If telescope see back.
(size)
- (5) screen 48" 65'
(length) (depth to top)
6 Doer 101
(size) (material)
- (6) pump 30 1000
(HP) (yield gpm)
Tractor
(type power)
- (7) electric log NO
(yes or no)
- (organization running log)
- (8) how well bottom plugged well

CODED

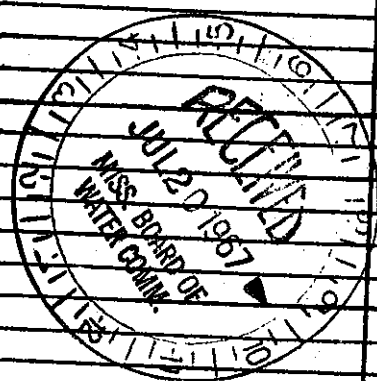

DRILLERS REMARKS: