

#2

Issaquena

A45

6-67

MISSISSIPPI BOARD OF WATER COMMISSIONERS
416 North State Street
Jackson, Mississippi 39201

CODED

WATER WELL DRILLERS LOG

July 30 1967 Five County Farmers Assn Issaquena
date well completed firm name county well located

LANDOWNER: DR E H WINN

description of formations encountered

from to

Greenville Miss
(mailing address)

Top Soil 14 14
Clayey fine sand 14 33 1/2
med sand 33 1/2 40
Clay + gravel layers 40 53
Sand + gravel 53 72 1/2
Coarse sand + gravel 72 1/2 112
Clay 112 118

WELL LOCATION:


sec. 20 T. 13 N R. 9 E
4 1/2 miles So of Mullins
(distance) (direction) (nearest town)

WELL PURPOSE: Irrigation
(home, irrigation, municipal, industrial)

WELL COMPLETION DATA:

- (1) diameter (inches) 6"
- (2) total depth (feet) 113'
- (3) static water level (feet) 17' below top of ground.
- (4) casing 6" pipe, 113' (material), (depth)
6" if telescope see back.
- (5) screen 48' 65' (length), (depth to top)
6" Doers #101 (size), (material)
- (6) pump 30 1000 (HP), (yield gpm)
Tractor (type power)
- (7) electric log NO (yes or no)

CODED

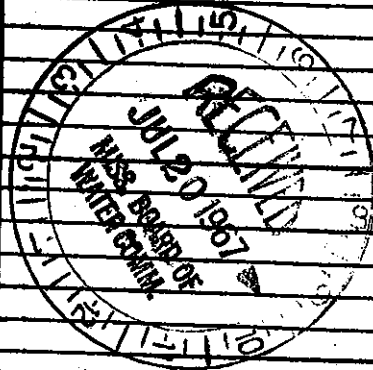

(organization running log)

(8) how well bottom plugged welded.

DRILLERS REMARKS: