

~~Washington~~ ISSAQUENA

Sharkey

A69

5-20-81

MISSISSIPPI  
BOARD OF WATER COMMISSIONERS  
416 North State Street  
Jackson, Mississippi 39201

CODED

WATER WELL DRILLERS LOG

Issaquena  
~~Washington~~

May 20 19 81  
date well completed

DREILING ASSOC  
firm name

SHARKEY  
county well located

LANDOWNER: GREEN Baggett  
P.O. Box 385  
Rolling Fork, MS 39157  
(mailing address)

description of formations encountered

from to

WELL LOCATION:  
sec. 36 T. 15 N. R. 8 E. S. 13 15  
(6 miles W) of Rolling Fork  
(distance) (direction) (nearest town)


Top Soil	0	5
CLAY	5	10
" "	10	15
" "	15	20
" "	20	25
" "	25	30
" "	30	35
CLAY FINE SD	35	40
FINE + MED SAND	40	45
" "	45	50
" "	50	55
MED + COARSE SAND	55	60
COURSE SAND + COAL	60	65
COURSE SAND + GRAVEL	65	70
" "	70	75
FINE + MED SAND	75	80
" "	80	85
COURSE SAND + GRA	85	90
" "	90	95
FINE + MED SAND	95	100
COURSE SAND + GRA	100	105
" "	105	110
" "	110	115
" "	115	120
" "	120	125
" "	125	130
Bottom of Hole	130	135

WELL PURPOSE:  
(home, irrigation, municipal, industrial)

WELL COMPLETION DATA:

- (1) diameter (inches) 16"
- (2) total depth (feet) 134'
- (3) static water level (feet) 12' below top of ground.
- (4) casing STEEL (material) 94' (depth)
- (5) screen 40' (length) 94' (depth to top)  
16" (size) STEEL (material)
- (6) pump 80 (HP) 1200 (yield gpm)  
Diesel (type power)
- (7) electric log NO (yes or no)  
NO (organization running log)
- (8) how well bottom plugged STEEL plug

CODED

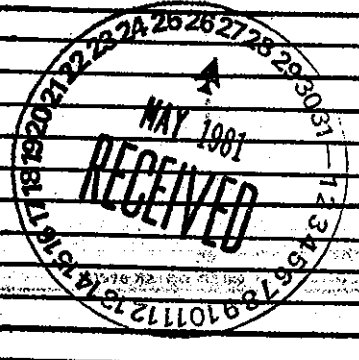

DRILLERS REMARKS: