

MISSISSIPPI DEPARTMENT OF NATURAL RESOURCES

Bureau of Land and Water Resources

Southport Mall

P.O. Box 10631

Jackson, Mississippi 39209


WATER WELL DRILLERS LOG

CODED

ISSAQUEENA
A 80

6-3-86 date well completed
Schultz Drilling firm name
ISSAQUEENA county well located

LANDOWNER	description of formations encountered	from	to
CHARLES Delaney P.O. Box 142 GRACE, MS (mailing address)	CLAY SAND COARSE SAND + pea gravel	0 21 40	21 40 120
WELL LOCATION: sec. 30 T. 13 N. R. 8 E 4 miles NE of Mayersville (distance) (direction) (nearest town)			
WELL PURPOSE: IRRIGATION (home, irrigation, municipal, industrial)			
WELL COMPLETION DATA:			
(1) diameter (inches) 16"			
(2) total depth (feet) 112'			
(3) static water level (feet) 29' below top of ground.			
(4) casing steel 72' (material) (depth)			
16" if telescope see back. (size)			
(5) screen 40' 72' 16" (length) (depth to top) (size) steel			
(6) pump 60 3000 (HP) (yield gpm)			
pto (type power)			
(7) electric log NO (yes or no)			
(organization running log)			
(8) how well bottom plugged CAP.			
DRILLERS REMARKS:			

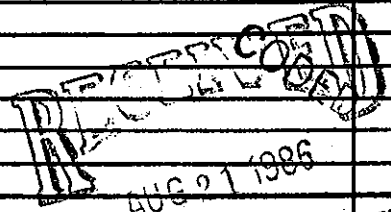

Department of Natural Resources
Bureau of Land & Water Resources