

State Well Report

Part 1

Mississippi Department of Environmental Quality
Office of Land and Water Resources
P.O. Box 10631
Jackson, MS 39289-0631
(601)961-5210
(601)354-6938 (fax)

For Office Use Only:

Aquifer: _____
Well #: A-117
L. S. Elevation: _____
E-log #: _____

County: Issaquena
Permit #: GW 41858
Irrigation Equipment
Driller: _____
Date drilling completed: 6-4-07

State Law requires that this report be prepared by the driller in detail and filed with the Department within 30 days of completion of drilling of the well.

Well Owner Information	Well Location
Owner Name: <u>D. W. Lee</u>	Latitude: <u>32° 55' 26.8</u> Longitude: <u>90° 59' 23.1</u>
Mailing Address: <u>P.O. Box 26</u>	Method of Lat/Long (circle one): Conventional Survey, USGS quad, Hand-held GPS, Survey-grade GPS
<u>Mayersville Ms. 39113</u> City State Zip Code	<u>SW SE 35</u> Twp <u>13N</u> Rng <u>8W</u> <u>SE</u> 1/4 <u>SE</u> 1/4 Sec.
Telephone No. () _____	Distance <u>4</u> Miles <u>NE</u> Direction of <u>Mayersville</u> Nearest Town

Well Data

Purpose of Well (circle one) Home Industrial Public Supply Irrigation Fish Culture Other: _____

Date well drilling started: 6-4-07 Date well drilling completed: 6-4-07

If flowing, method of flow regulation: Valve _____ Other (describe) _____

Static Water Level: 12 feet above or below (circle one) land surface Date measured: 6-5-07

Method of Measurement (circle one) steel tape electric tape air line other: _____

Hole depth: 107 Well depth: 107 Well grouted to a depth of 10 feet

Type of grout (circle one): Cement Bentonite Mix

Casing length: 67 feet Casing diameter: 16 inches Type of casing: PVC Sch 40

Screen length: 40 feet Screen diameter: 16 inches Type of screen: PVC Sch 40

Screen slot size: .050 inches Setting depth: From 68 feet to 107 feet

Type of completion (circle all applicable): Gravel packed Underreamed Telescoped Open hole Natural Development
Other (describe): _____

Top of lap pipe or reduction in casing: _____ feet. If telescoped or more than one screen, describe on back of page


Logs run (circle all applicable): No log run Electric Gamma Ray Density Sonic Neutron Other: _____

Name of organization running log(s):

I certify that the well was drilled, constructed, and completed in accordance with all applicable requirements of the Mississippi Department of Environmental Quality and/or the Mississippi Department of Health regulations and state laws.

Irrigation Equipment Inc.
Patrick M. Chism 0695

Print Name of Water Well Contractor and License No.

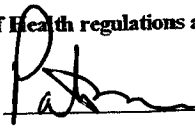
Signature of Water Well Contractor

STATE WELL REPORT

Part 2

Pump Installer's Completion Report
 Mississippi Department of Environmental Quality
 Office of Land and Water Resources
 P.O. Box 10631
 Jackson, MS 39289-0631
 (601)961-5210
 (601)354-6938 (fax)

County: Issaquena
 Permit #: GW 41858
 Driller: _____
 Date completed: 6-4-07

For Office Use Only:

Aquifer: _____
 Well #: A-117
 Elevation: _____

This report should be prepared by the pump installer in detail and filed with the Department within 30 days of the installation of pump.

Well Owner Information	Well Location
Owner Name: <u>D. W. Lee</u>	Latitude: _____ Longitude: _____
Mailing Address: <u>P.O. Box 26</u>	Method of Lat/Long (circle one): <u>Conventional Survey</u>
<u>Mayersville Ms. 39113</u>	<u>SW</u> USGS quad, Hand-held GPS, Survey-grade GPS
<small>City State Zip Code</small>	<u>SE</u> ¼ <u>SE</u> ¼ Sec <u>35</u> Twn <u>13N</u> Rng <u>8W</u>
Telephone No. () _____	Distance Direction Nearest Town
	<u>4</u> Miles <u>NE</u> of <u>Mayersville</u>

Pump Type Circle one	Power Type Circle one
Air Lift Jet Submersible	<u>Diesel Engine</u> Gasoline Engine Natural Gas
Bucket Piston <u>Turbine</u>	Electric Motor Hand Tractor PTO
Centrifugal Rotary Flowing Well	Windmill Other (specify): _____
Other (specify): _____	Horse Power Rating of Motor: <u>60</u>
Date Pump Installed: <u>6-5-07</u>	Setting Depth: <u>70</u> feet
Rated Pump Capacity: <u>2800±</u> Gallons Per Minute	Number of Stages: <u>1</u>

Pump Test Data	Method of Measuring Water Level Circle one
Date Well Tested: _____	Air Line Electric Measuring Line Steel Tape
Static Water Level (A): _____ Feet Below Land Surface	Other (specify): _____
Pumping Water Level (B): _____ Feet Below Land Surface	For flowing well, measured shut in head: _____ feet
Drawdown [(B) - (A)]: _____ Feet Below Land Surface	Well yielded _____ GPM with a drawdown of _____ feet after _____ hours of pumping
Test Pumping Rate: _____ Gallons Per Minute	
Duration of Pump Test (minimum 4 hours): _____ hours	

I HEREBY CERTIFY that the above statements are true to the best of my knowledge.


Patrick M. Chism 0695
 Print Name of Pump Installer and License No. (if applicable)

[Signature]
 Signature of Pump Installer

D. W. Lee Map

6W41858

A-117

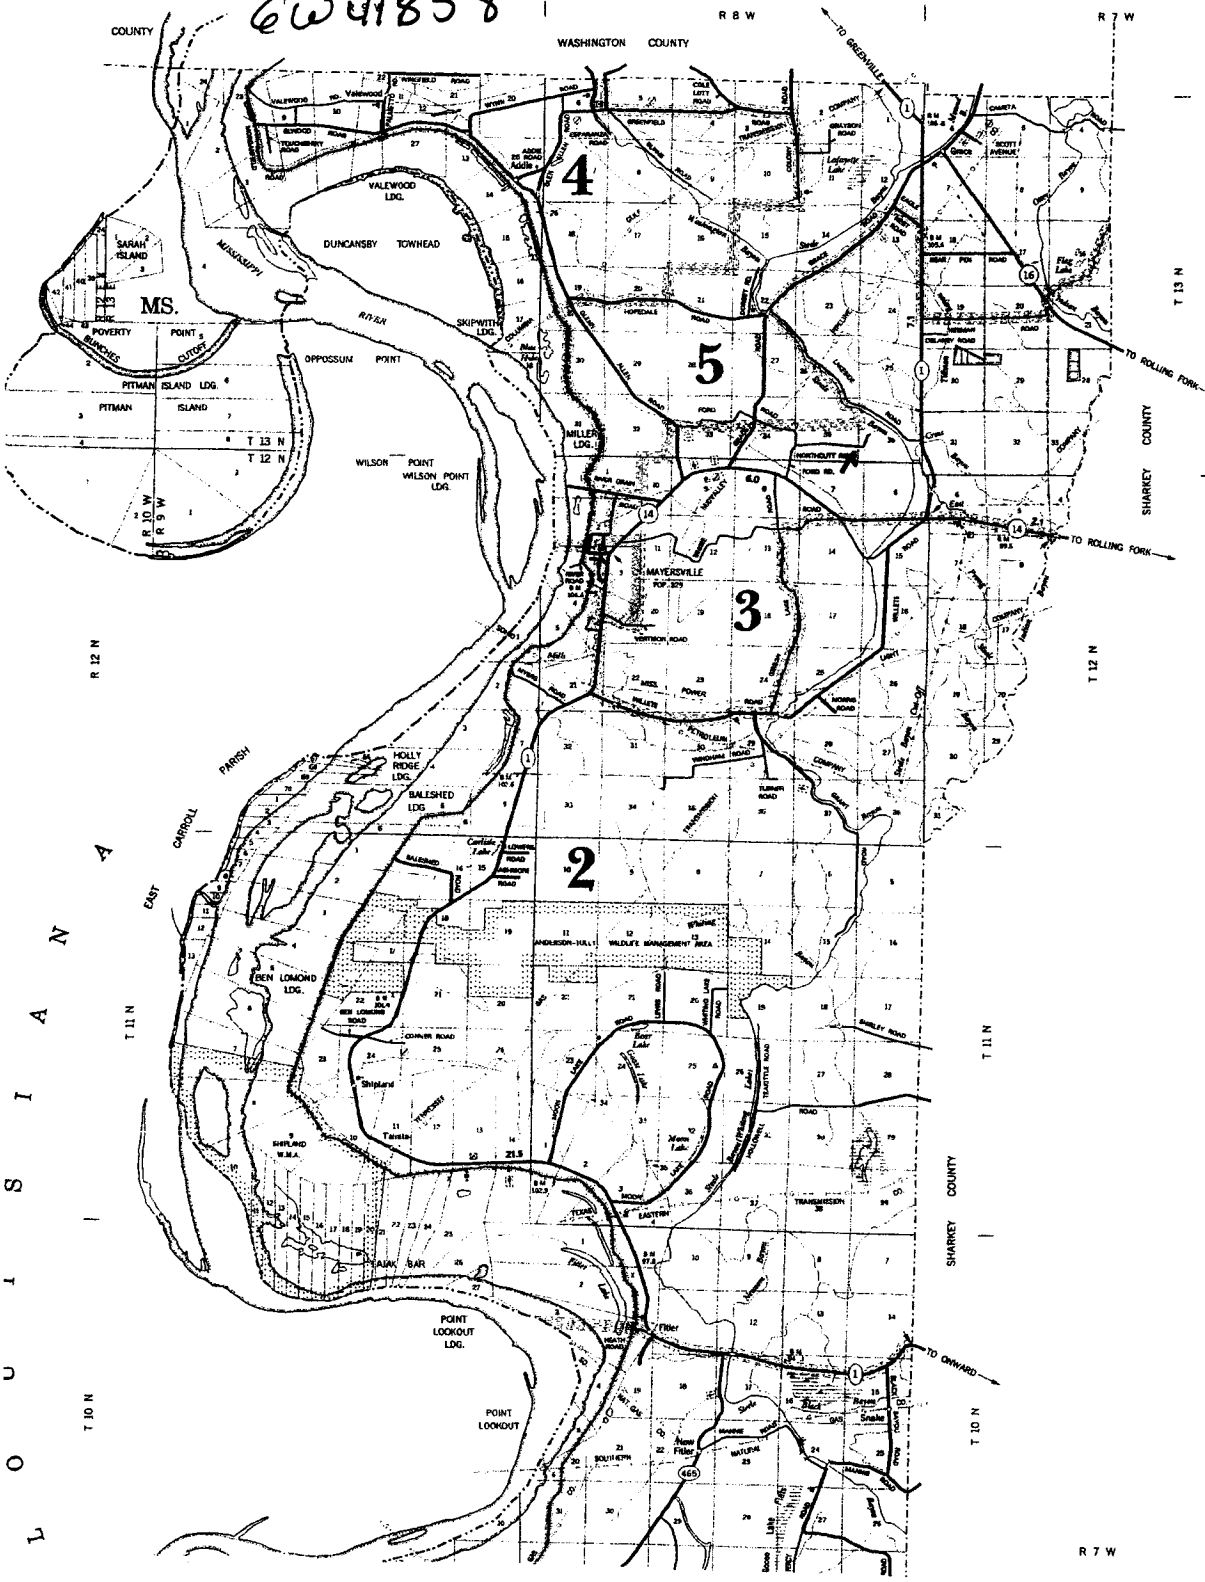

LEGEND

- ROADS AND ROADWAY FEATURES**
- UNIMPROVED ROAD
 - GRAVEL ROAD
 - PAVED ROAD
 - UNPAVED HIGHWAY
 - GRAVEL HIGHWAY
 - INTERSTATE SYSTEM
 - CITY STREET
- HIGHWAY BRIDGES**
- BRIDGE 50 FEET AND OVER
 - DRAINAGE
 - FERRY (FREE OR TOLL)
 - HIGHWAY BRIDGE SEPARATION
 - HIGHWAY INTERCHANGE
- ROAD SYSTEM DESIGNATION**
- INTERSTATE NUMBERED
 - U.S. NUMBERED
 - STATE NUMBERED
- RAILROADS**
- RAILROAD STATION
 - GRADE CROSSING
 - RAILROAD ABOVE
 - RAILROAD BELOW
- AIRPORTS**
- MILITARY AIRPORT
 - AIRPORT LIMITED FACILITIES
 - LANDING AREA OR STRIP
 - INCLUDING PRIVATE AIR FIELDS
 - AIRPORT COMPLETE FACILITIES
 - AIRPORT LIGHT BEACON
- DRAINAGE AND NATURAL FEATURES**
- NARROW STREAM
 - DRAINAGE DITCH
 - LAKES AND RESERVOIRS
 - OVERFLOW LAND
 - MARSH OR SWAMP LAND
- BOUNDARIES**
- STATE BOUNDARY
 - COUNTY BOUNDARY
 - BEAT LINE
 - CONGRESSIONAL TOWNSHIP
 - SECTION LINE
 - NATION OR STATE PURCH
 - RESERVATION FRING ETC
 - URBAN AREA COMPACT
 - INCORPORATED PLACES
 - UNINCORPORATED SEPARATED AREAS

L O U I S I A N A

SHARKEY COUNTY

RECORDED
JUN 18 1907
BY CLWR