

State Well Report

Part 1

Mississippi Department of Environmental Quality
Office of Land and Water Resources
P.O. Box 10631
Jackson, MS 39289-0631
(601)961-5210
(601)354-6938 (fax)

For Office Use Only:

Aquifer: _____
Well #: A-122
L. S. Elevation: _____
E-log #: _____

County: Issaquena
Permit #: 6012383
Driller: Irrigation Equipment
Date drilling completed: 3-20-08

State Law requires that this report be prepared by the driller in detail and filed with the Department within 30 days of completion of drilling of the well.

Well Owner Information	Well Location
Owner Name: <u>Esperanza Planting Co</u>	Latitude: <u>33° 00' 16.6"</u> Longitude: <u>91° 04' 27.7"</u>
Mailing Address: <u>P.O. Box 286</u>	Method of Lat/Long (circle one): Conventional Survey, USGS quad, Hand-held GPS, Survey-grade GPS
<u>Glen Allen Ms. 38744</u> City State Zip Code	<u>NE 1/4 SE 1/4 Sec 20 Twn 13N Rng 9W</u>
Telephone No. <u>662 839-2053</u>	Distance <u>2</u> Miles <u>South</u> Direction of <u>Glen Allen</u> Nearest Town
Well Data	
Purpose of Well (circle one) Home Industrial Public Supply <u>Irrigation</u> Fish Culture Other: _____	
Date well drilling started: <u>3-20-08</u> Date well drilling completed: <u>3-20-08</u>	
If flowing, method of flow regulation: Valve _____ Other (describe) _____	
Static Water Level: <u>15</u> feet above or <u>below</u> (circle one) land surface Date measured: <u>3-21-08</u>	
Method of Measurement (circle one) <u>steel tape</u> electric tape air line other: _____	
Hole depth: <u>127</u> Well depth: <u>127</u> Well grouted to a depth of <u>10</u> feet	
Type of grout (circle one): Cement <u>Bentonite</u> Mix	
Casing length: <u>87</u> feet Casing diameter: <u>16</u> inches Type of casing: <u>PVC</u>	
Screen length: <u>40</u> feet Screen diameter: <u>16</u> inches Type of screen: <u>PVC</u>	
Screen slot size: <u>.050</u> inches Setting depth: From <u>88</u> feet to <u>127</u> feet	
Type of completion (circle all applicable): <u>Gravel packed</u> Underreamed Telescoped Open hole Natural Development Other (describe): _____	
Top of lap pipe or reduction in casing: _____ feet. If telescoped or more than one screen, describe on back of page	
Logs run (circle all applicable) <u>No log run</u> Electric Gamma Ray Density Sonic Neutron Other: _____	
Name of organization running log(s): _____	
I certify that the well was drilled, constructed, and completed in accordance with all applicable requirements of the Mississippi Department of Environmental Quality and/or the Mississippi Department of Health regulations and state laws.	
Irrigation Equipment Inc Patrick M. Chism 0695	
Print Name of Water Well Contractor and License No.	Signature of Water Well Contractor

RECEIVED
MAR 28 2008
BY: OLWR

STATE WELL REPORT

Part 2

Pump Installer's Completion Report
 Mississippi Department of Environmental Quality
 Office of Land and Water Resources
 P.O. Box 10631
 Jackson, MS 39289-0631
 (601)961-5210
 (601)354-6938 (fax)

County: Issaquena
 Permit #: 6642383
 Irrigation Equipment
 Driller: _____
 Date completed: 3-20-08

For Office Use Only:

Aquifer: _____
 Well #: A-122
 Elevation: _____

This report should be prepared by the pump installer in detail and filed with the Department within 30 days of the installation of pump.

Well Owner Information	Well Location
Owner Name: <u>Esperanza Planting Co.</u>	Latitude: _____ Longitude: _____
Mailing Address: <u>P.O. Box 286</u>	Method of Lat/Long (circle one): Conventional Survey, USGS quad, Hand-held GPS, Survey-grade GPS
<u>Glen Allen Ms. 38744</u> City State Zip Code	<u>NE 1/4 SE 1/4 Sec 20 Twn 13N Rng 9W</u>
Telephone No. <u>(662) 839-2053</u>	Distance Direction Nearest Town <u>2 Miles South of Glen Allen</u>

Pump Type Circle one	Power Type Circle one
Air Lift Jet Submersible	Diesel Engine Gasoline Engine Natural Gas
Bucket Piston <u>Turbine</u>	<u>Electric Motor</u> Hand Tractor PTO
Centrifugal Rotary Flowing Well	Windmill Other (specify): _____
Other (specify): _____	Horse Power Rating of Motor: <u>60</u>
Date Pump Installed: <u>3-21-08</u>	Setting Depth: <u>60</u> feet
Rated Pump Capacity: <u>2800 ±</u> Gallons Per Minute	Number of Stages: <u>1</u>

Pump Test Data	Method of Measuring Water Level Circle one
Date Well Tested: _____	Air Line Electric Measuring Line Steel Tape
Static Water Level (A): _____ Feet Below Land Surface	Other (specify): _____
Pumping Water Level (B): _____ Feet Below Land Surface	For flowing well, measured shut in head: _____ feet
Drawdown [(B) - (A)]: _____ Feet Below Land Surface	Well yielded _____ GPM with a drawdown of
Test Pumping Rate: _____ Gallons Per Minute	_____ feet after _____ hours of pumping
Duration of Pump Test (minimum 4 hours): _____ hours	

I HEREBY CERTIFY that the above statements are true to the best of my knowledge.

Patrick M. Chism 0695
 Print Name of Pump Installer and License No. (if applicable)

[Signature]
 Signature of Pump Installer

RECEIVED
 MAR 28 2008
 BY: OLWR

Esperanza Planting Co. Map


A-122

R 9 W 66642383

R 8 W

R 7 W

WASHINGTON COUNTY

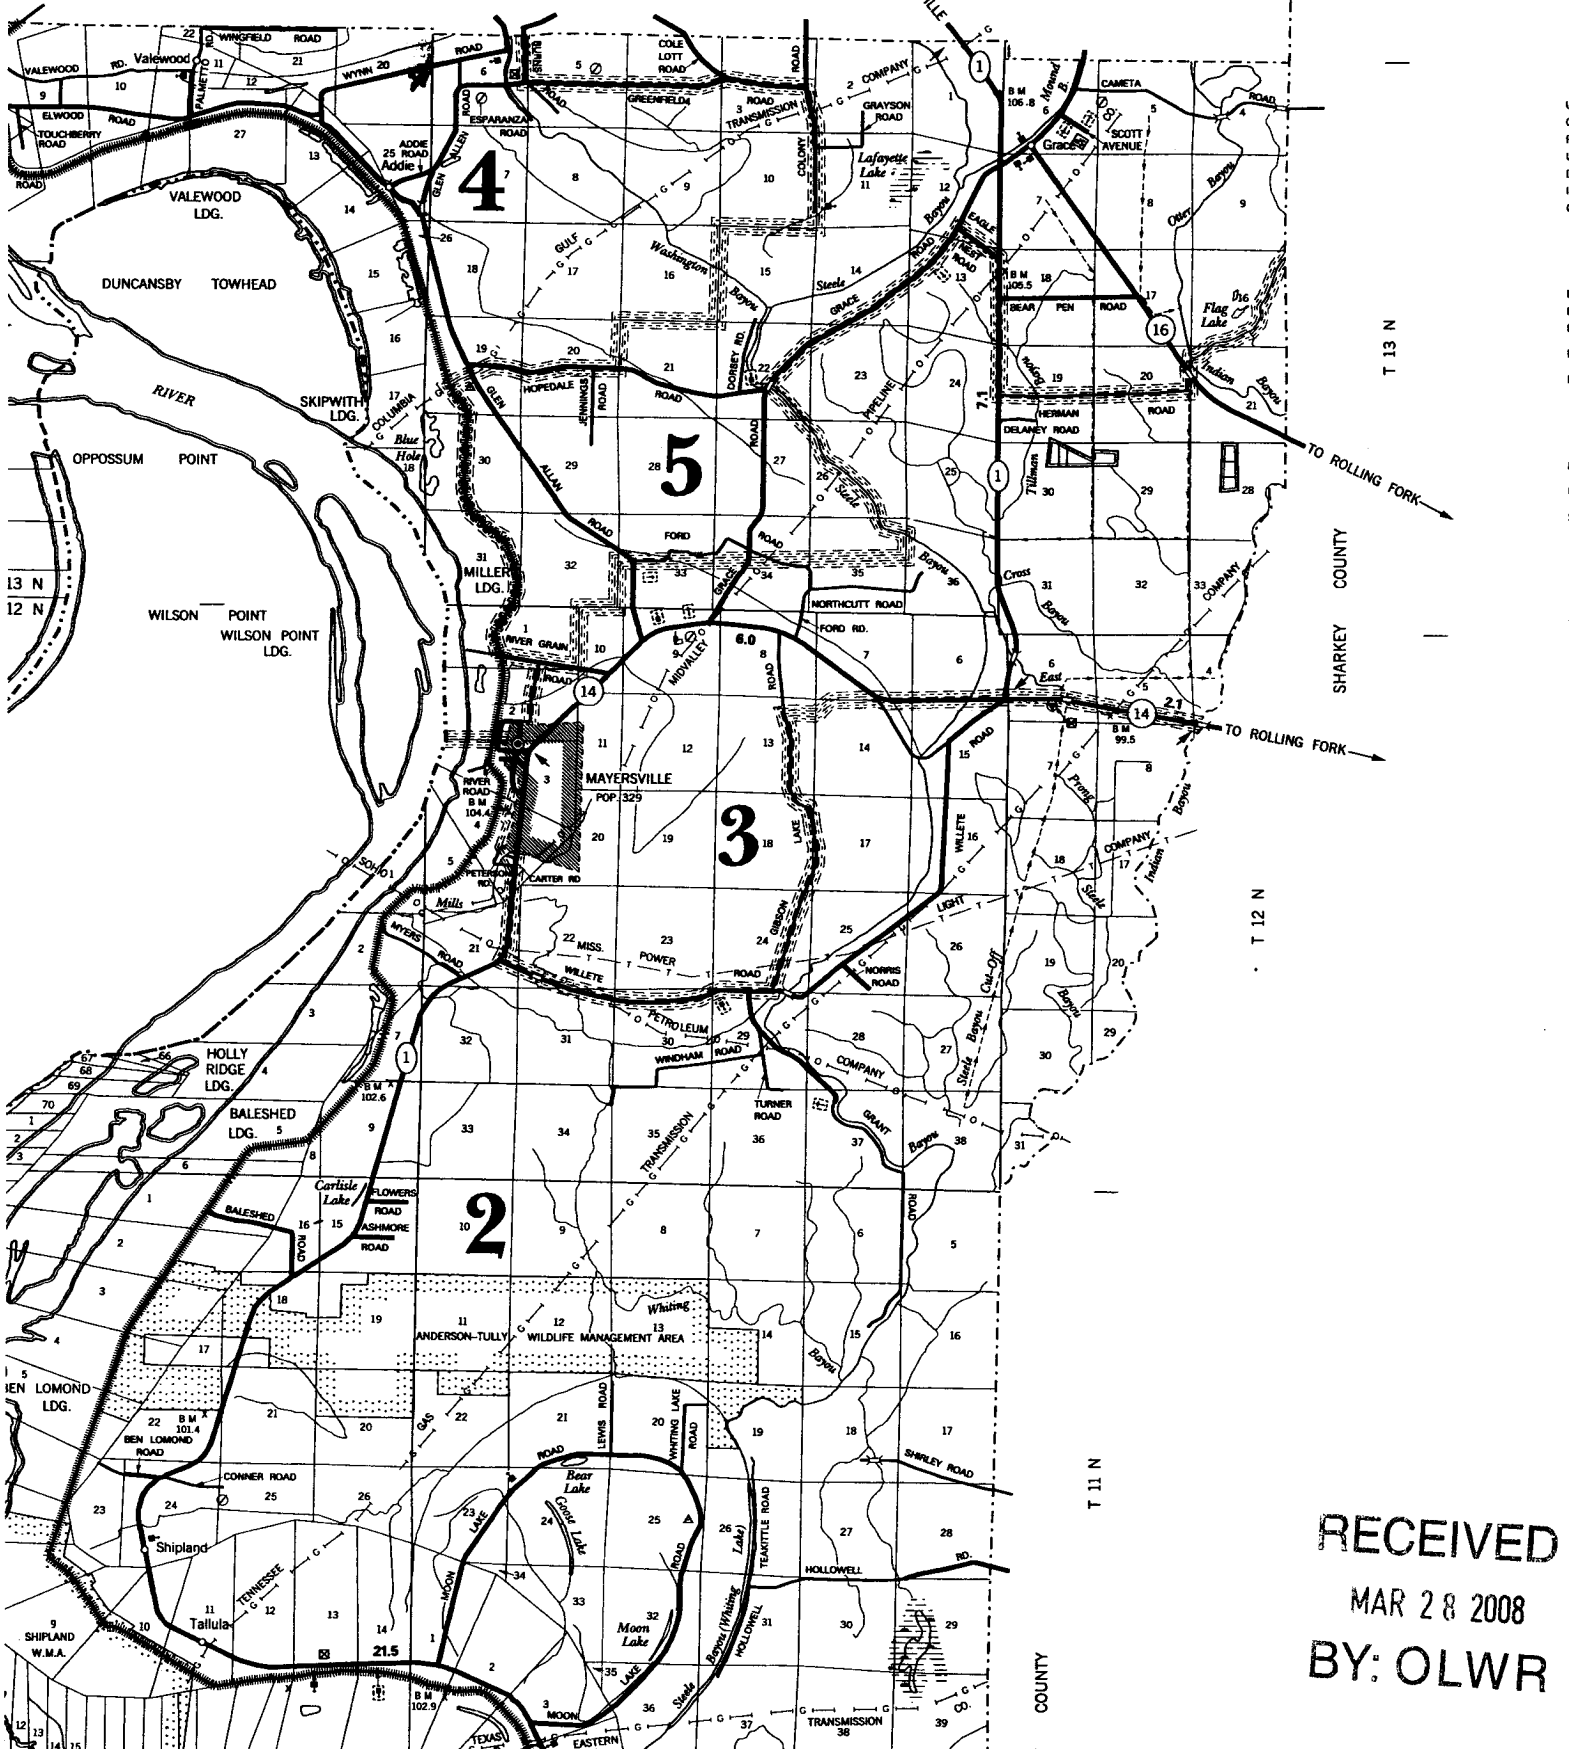

RECEIVED
 MAR 28 2008
 BY: OLWR