

MISSISSIPPI DEPARTMENT OF ENVIRONMENTAL QUALITY

Office of Land and Water Resources

P. O. Box 10631

Jackson, MS 39289-0631

WATER WELL DRILLERS LOG

COUNTY WELL LOCATED Issaquena	
WELL NUMBER A-2019	CODED
DATE WELL COMPLETED 9-18-01	

PERMIT NUMBER
NAME OF DRILLING FIRM Irrigation Equipment Inc.
Indianola, MS

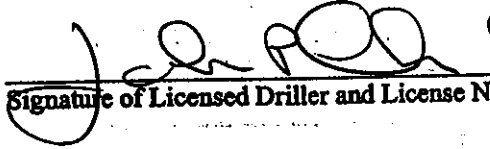
NAME & MAILING ADDRESS OF LANDOWNER W.C. Woodruff
586 Grace Rd. Glen Allan, MS 38744
Latitude: Longitude:
WELL LOCATION: SEC <u>6</u> TOWNSHIP <u>13N</u> RANGE <u>7W</u> E
DISTANCE <u>North</u> DIRECTION <u>of</u> NEAREST TOWN <u>Grace</u>
Miles
OTHER LANDMARK
WELL PURPOSE: Home, Irrigation, Municipal, Industrial, Fish Pond, etc. Irrigation

PUMP DATA		
PUMP TYPE (Circle One): Submersible, <u>Turbine</u> , Jet, Flowing Well, Other (Describe)		
POWER TYPE (Circle One): <u>Electric</u> , Tractor, Diesel, Gasoline, Butane, Other (Describe) <u>60</u> H/P		
DESCRIPTION OF FORMATIONS ENCOUNTERED	FROM	TO
Clay	0	31
Fine Sand	31	65
Med. Sand/gravel	65	110
Fine Sand	110	116
Med. Sand/gravel	116	135
Screen	70-110	
Blank	110-117	
Screen	117-135	
REC'D DEC 17 2001		
Top of Lap Pipe or Reduction in Casing		
FEET	IF TELESCOPED OR MORE THAN ONE SCREEN: USE BACK PAGE	

WELL DATA		
Well Depth 135	Casing Diameter (In.) 16	Casing Length (Ft.) 77
Type of Casing pvc	Hole Depth 135	Depth to Static Water Level 6ft.
TYPE OF COMPLETION: (Circle One or More): <u>Gravel Packed</u> , Underreamed, Telescoped, Natural Development, Open Hole, Other (Describe)		
WELL GROUTED TO A DEPTH OF _____ FEET Type Grout (circle one): Cement, Bentonite, or Mix		

SCREEN DATA		
Diameter - inches 16	Length - Feet 58ft.	Slot Size - inches .050
Screen Type pvc	Depth to Bottom - Feet	

I certify that the well was drilled, constructed and completed in accordance with all applicable Requirements of the Mississippi Department of Environmental Quality and/or the Mississippi Department of Health regulations and state laws.

 0-439 12-14-01
Signature of Licensed Driller and License No. Date

Additional Information Required On Back