

ISSAQUENA MISSISSIPPI BOARD OF WATER COMMISSIONERS

B 22
8-26-61


WATER WELL DRILLERS LOG

CODED

B-22

Date: AUG. 26, 1961, Driller: DELTA DRILLING Co. County ISSAQUENA
(Name)

TOWN OF MAYERSVILLE BOARD OF SUPERVISORS		Description & Color of Materials Sand, Clay, Red Clay, Shell, etc.	Thick- ness Feet	Depth Feet
(1) Owner of Land: <u>MAYERSVILLE, MISS.</u> (Name) <u>MAYERSVILLE, MISS.</u> (Address)		GUMBO	22	22
		SAND	64	86
(2) Location: $\frac{1}{4}$, $\frac{1}{4}$, Sec. <u>3</u> T. <u>12N</u> R. <u>8W</u>		GRAVEL	59	145
<u>3</u> miles (distance), of (direction), of (Nearest Town)		SAND	169	316
(3) Topography: (Hilly) (Flat) (Level)		SHALE	21	337
(4) Purpose of Well: <u>MUNICIPAL</u> (Domestic Irrigation, Municipal, Industrial, Other)		SAND	94	431
		SHALE w/3" ROCK	31	462
		SANDY SHALE	41	503
		GUMBO w/6" ROCK	42	545
		SHALE w/6" ROCK	42	587
		SAND + SHALE - 4" ROCK at 650'	83	690
Information upon completion of well:		SHALE w/4" ROCK	22	692
(1) Diameter <u>6</u> inches.		SAND	12	704
(2) Total Depth <u>823</u> feet.		SHALE	7	711
(3) Water Level _____ feet below top of ground.		GUMBO w/SHALE STREAKS	22	733
(4) Cased to <u>823</u> , Size <u>6"-166'</u> <u>4"-336'</u> <u>2 1/2"-815'</u>		SHALE	15	748
(5) Screen: Size <u>2 1/2</u> , Length <u>30'</u>		SAND	16	764
(6) Were any formations sealed against pollution? _____ yes, _____ no.		SHALE	9	776
If YES depth of formation _____		SAND - CODED	80	823
Why _____				
Drillers Remarks: <u>24'-LAP OF 2 1/2" IN 4" PIPE</u> <u>NO. 12-E RED JACKET DEEP WELL SUB-</u> <u>MERSIBLE PUMP SET 42' IN WELL.</u>				

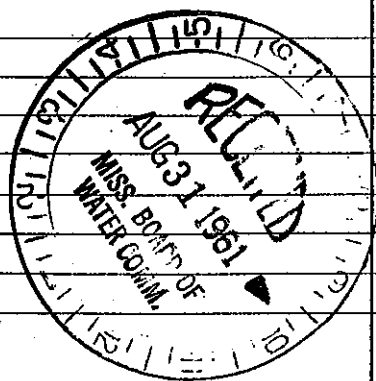

(Use Back Side)

Well No.

Mail this copy to Board of Water Commissioners 429 Miss. St. Jackson, Miss.