

MISSISSIPPI BOARD OF WATER COMMISSIONERS

ISSAQUENA

WATER WELL DRILLERS LOG

CODED


B33

8-19-61

Date: AUG. 19, 1961, Driller: DELTA DRILLING Co. County ISSAQUENA
(Name)

(1) Owner of Land: DANIELS + STAFFORD (Name) RANCH	Description & Color of Materials Sand, Clay, Red Clay, Shell, etc.	Thick- ness Feet	Depth Feet
<u>ROLLING FORK MISS-</u> (Address)	GUMBO	22	22
(2) Location: <u>1/4, 1/4, Sec. 6, 14, 517 T12R8,</u> miles _____ of _____ (distance) (direction) (Nearest Town)	SAND	82	104
(3) Topography: _____ (Hilly) (Flat) (Level)	GRAVEL	29	133
(4) Purpose of Well: <u>DOMESTIC -</u> (Domestic Irrigation Municipal, Industrial, Other)	GUMBO	14	147
Information upon completion of well:	SAND (BROWN)	160	307
(1) Diameter: <u>4 1/2</u> inches.	GUMBO w/ SAND STREAKS	43	350
(2) Total Depth: <u>987</u> feet.	SAND -	63	413
(3) Water Level: <u>4</u> feet below top of ground.	SHALE	42	455
(4) Cased to: <u>987</u> , Size: <u>4" - 147</u> <u>2" - 840</u>	GUMBO w/ 8" ROCK @ 612'	192	647
(5) Screen: Size: <u>2"</u> , Length: <u>20'</u>	SHALE	72	719
(6) Were any formations sealed against pollution? _____ yes, _____ no.	GUMBO w/ 10" ROCK @ 886'	187	906
If YES depth of formation _____	SAND	81	987
Why _____			
Drillers Remarks: <u>RED JACKET DEEP</u>			
<u>WELL SUBMERSIBLE PUMP SET</u>			
<u>45' IN WELL - 20' LAP OF</u>			
<u>2" PIPE IN 4" PIPE</u>			

CODED

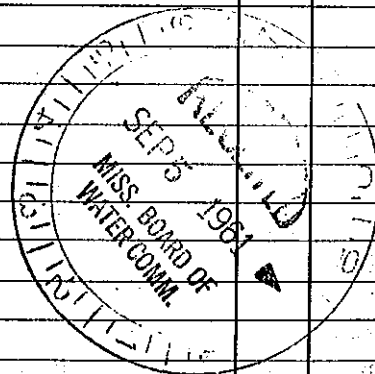

Well No.

(Use Back Side)

Mail this copy to Board of Water Commissioners 429 Miss. St. Jackson, Miss.