

County: Issaquena  
 Permit #: BW-44402  
 Irrigation Equipment  
 Date drilling completed: 3-3-11

**State Well Report**  
**Part 1 - Driller's Log**  
 Mississippi Department of Environmental Quality  
 Office of Land and Water Resources  
 P.O. Box 2309  
 Jackson, MS 39225  
 (601)961-5210  
 (601)961-5228 (fax)

For Office Use Only:  
 Aquifer: B 73  
 Well #: \_\_\_\_\_  
 L. S. Elevation: \_\_\_\_\_  
 E-log #: \_\_\_\_\_

State Law requires that this report be prepared by the license holder responsible for the work and filed with the Department at the above address within 30 days of completion of drilling of the well or borehole.

Information on Well Owner (Landowner if borehole is not for a water well)		Well or Borehole Location	
Owner Name: <u>Albert Mahalite</u>		Latitude: <u>32.54.09.6</u>	Longitude: <u>90.58.39.2</u>
Mailing Address: <u>6500 Hwy 14 west</u>		Method of Lat/Long (circle one): Conventional Survey, USGS quad, Hand-held GPS, Survey-grade GPS	
<u>Rolling Fork MS 39159</u>		<u>SE 1/4 NW 1/4 Sec. 15 Twn 12N Rng 8W</u>	
Telephone No. ( ) _____		Distance: <u>4</u> Miles	Direction: <u>E</u> of Nearest Town: <u>Mayersville</u>

**Well / Borehole Data**

Date drilling started: 3-3-11 Date drilling completed: 3-3-11 Hole depth: 124 Hole diameter: 24"

Location of the source of any surface water used for drilling: Surface Water

Method of dosing and volume of Chlorine used in drilling and development: 50 PPM

Logs run (circle all applicable): No log run Electric Gamma Ray Density Sonic Neutron Other: \_\_\_\_\_

Name of organization running log(s): \_\_\_\_\_

Purpose of borehole (check one): Water Well  Geotechnical/Geological Investigation \_\_\_\_\_ Ground Source Heat Pump \_\_\_\_\_  
 Seismic Survey \_\_\_\_\_ Other (describe) \_\_\_\_\_

*If driller is not related to water well construction, skip the remainder of this block.*

Purpose of Well (check one): Home \_\_\_\_\_ Industrial \_\_\_\_\_ Public Supply \_\_\_\_\_ Irrigation  Fish Culture \_\_\_\_\_ Other: \_\_\_\_\_

If a flowing well, method of flow regulation: Valve \_\_\_\_\_ Other (describe) \_\_\_\_\_

Static Water Level: \_\_\_\_\_ feet above or below (circle one) land surface Date measured: \_\_\_\_\_

Method of Measurement (circle one): steel tape electric tape air line other: \_\_\_\_\_

Well depth: 124 Well grouted to a depth of 10 feet Type of grout (circle one): Neat Cement Bentonite Mix

Casing length: 84 feet Casing diameter: 16 inches Type of casing: PVC

Screen length: 40 feet Screen diameter: 16 inches Type of screen: PVC

Screen slot size: .050 inches Setting depth: From 85 feet to 124 feet

Type of completion (circle all applicable): Gravel packed Underreamed Telescoped Open hole Natural Development  
 Other (describe): \_\_\_\_\_

Top of lap pipe or reduction in casing: \_\_\_\_\_ feet *If telescoped or more than one screen, describe on next page*

Form: OLWR-SWR-1A (04/08)


RECEIVED  
 MAR 15 2011  
 BY OLWR

673

The sketch below only required for water wells.

If well telescopes, show depths on sketch.

Ground Level \_\_\_\_\_

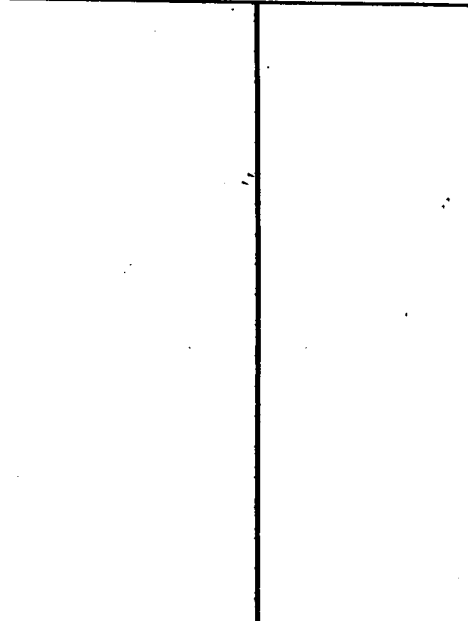

Description of formations encountered must be provided for all wells and boreholes, unless specifically exempted by regulations.

Description of Formations Encountered	From (depth)	To (depth)
Clay	Ground Level	38
Fine Sand	39	49
Medium Sand + Gravel	50	124

If more than one screen, show location of each on sketch.

Sketch the property layout and include the following: 1) the well location; 2) any permanent structures on the property that may aid in locating the well; 3) any roads, power lines, or other items that may aid in locating the property and the well; 4) a north arrow.

Landowner Name: \_\_\_\_\_

Form: OLWR-SWR-1A (04/08)

I certify that the well/borehole was drilled, constructed, and completed in accordance with all applicable requirements of the Mississippi Department of Environmental Quality and the Mississippi Department of Health regulations, if applicable, and state laws.

Patrick M Chism      0695

Print Name of Responsible Licensee and License No.      Date      Signature of Licensee

RECEIVED  
MAY 15 2011  
BY: OLWR

County: Issaquena  
 Permit #: CW-44402  
 Irrigation Equipment  
 Driller:  
 Date completed: 3-3-11  
 Copy information from block on Part 1

### STATE WELL REPORT

#### Part 2

Pump Installer's Completion Report  
 Mississippi Department of Environmental Quality  
 Office of Land and Water Resources  
 P.O. Box 2309  
 Jackson, MS 39225  
 (601)961-5210  
 (601)961-5228 (fax)

For Office Use Only:  
 Aquifer: \_\_\_\_\_  
 Well #: \_\_\_\_\_  
 Elevation: \_\_\_\_\_

This part of the report must be completed by a licensed water well contractor or a licensed pump installer. A copy of Part 1 of the report must be attached and both parts filed with the Department at the above address within 30 days of well completion.

Well Owner Information	Well Location
Owner Name: <u>Albert Mahalik</u>	Latitude: _____ Longitude: _____
Mailing Address: <u>6500 Hwy 14 West</u>	Method of Lat/Long (check one): Conventional Survey _____
<u>Rolling Fork MS 39159</u>	USGS quad _____, Hand-held GPS _____, Survey-grade GPS _____
City State Zip Code	<u>SE 1/4 NW 1/4 Sec 15 T 12N R 8W</u>
Telephone No. ( ) _____	Distance _____ Direction _____ Nearest Town _____
	<u>4 Miles E of Mayersville</u>

Pump Type	Power Type
Circle one	Circle one
Air Lift <input type="checkbox"/>	Diesel Engine <input type="checkbox"/>
Jet <input type="checkbox"/>	Gasoline Engine <input checked="" type="checkbox"/>
<u>Submersible</u> <input checked="" type="checkbox"/>	Natural Gas <input type="checkbox"/>
Bucket <input type="checkbox"/>	Electric Motor <input checked="" type="checkbox"/>
Piston <input type="checkbox"/>	Hand <input checked="" type="checkbox"/>
Turbine <input type="checkbox"/>	Tractor PTO <input type="checkbox"/>
Centrifugal <input type="checkbox"/>	Windmill <input type="checkbox"/>
Rotary <input type="checkbox"/>	Other (specify): _____
Flowing Well <input type="checkbox"/>	Other (specify): _____
Other (specify): _____	Other (specify): _____
Date Pump Installed: _____	Horse Power Rating of Motor: <u>30</u>
Rated Pump Capacity: <u>1150±</u> Gallons Per Minute	Setting Depth: <u>70</u> feet
	Number of Stages: <u>1</u>

Pump Test Data	Method of Measuring Water Level
Date Well Tested: _____	Circle one
Static Water Level (A): _____ Feet Below Land Surface	Air Line <input type="checkbox"/>
Pumping Water Level (B): _____ Feet Below Land Surface	Electric Measuring Line <input checked="" type="checkbox"/>
Drawdown [(B) - (A)]: _____ Feet Below Land Surface	Steel Tape <input type="checkbox"/>
Test Pumping Rate: _____ Gallons Per Minute	Other (specify): _____
Duration of Pump Test (minimum 4 hours): _____ hours	For flowing well, measured shut in head: _____ feet
	Well yielded _____ GPM with a drawdown of _____ feet after _____ hours of pumping

This is for (circle one):  New Well  Replacement of Existing Pump  Repair of Existing Pump

I HEREBY CERTIFY that the above statements are true to the best of my knowledge.  
 Patrick M Chism 0695  
 Print Name of Pump Installer and License No. (if applicable) \_\_\_\_\_  
 Signature of Pump Installer \_\_\_\_\_


Form: OLWR-SWR-1C (07-09)

RECEIVED  
 MAR 15 2011  
 BY OLWR

R 8 W

R 7 W

COUNTY

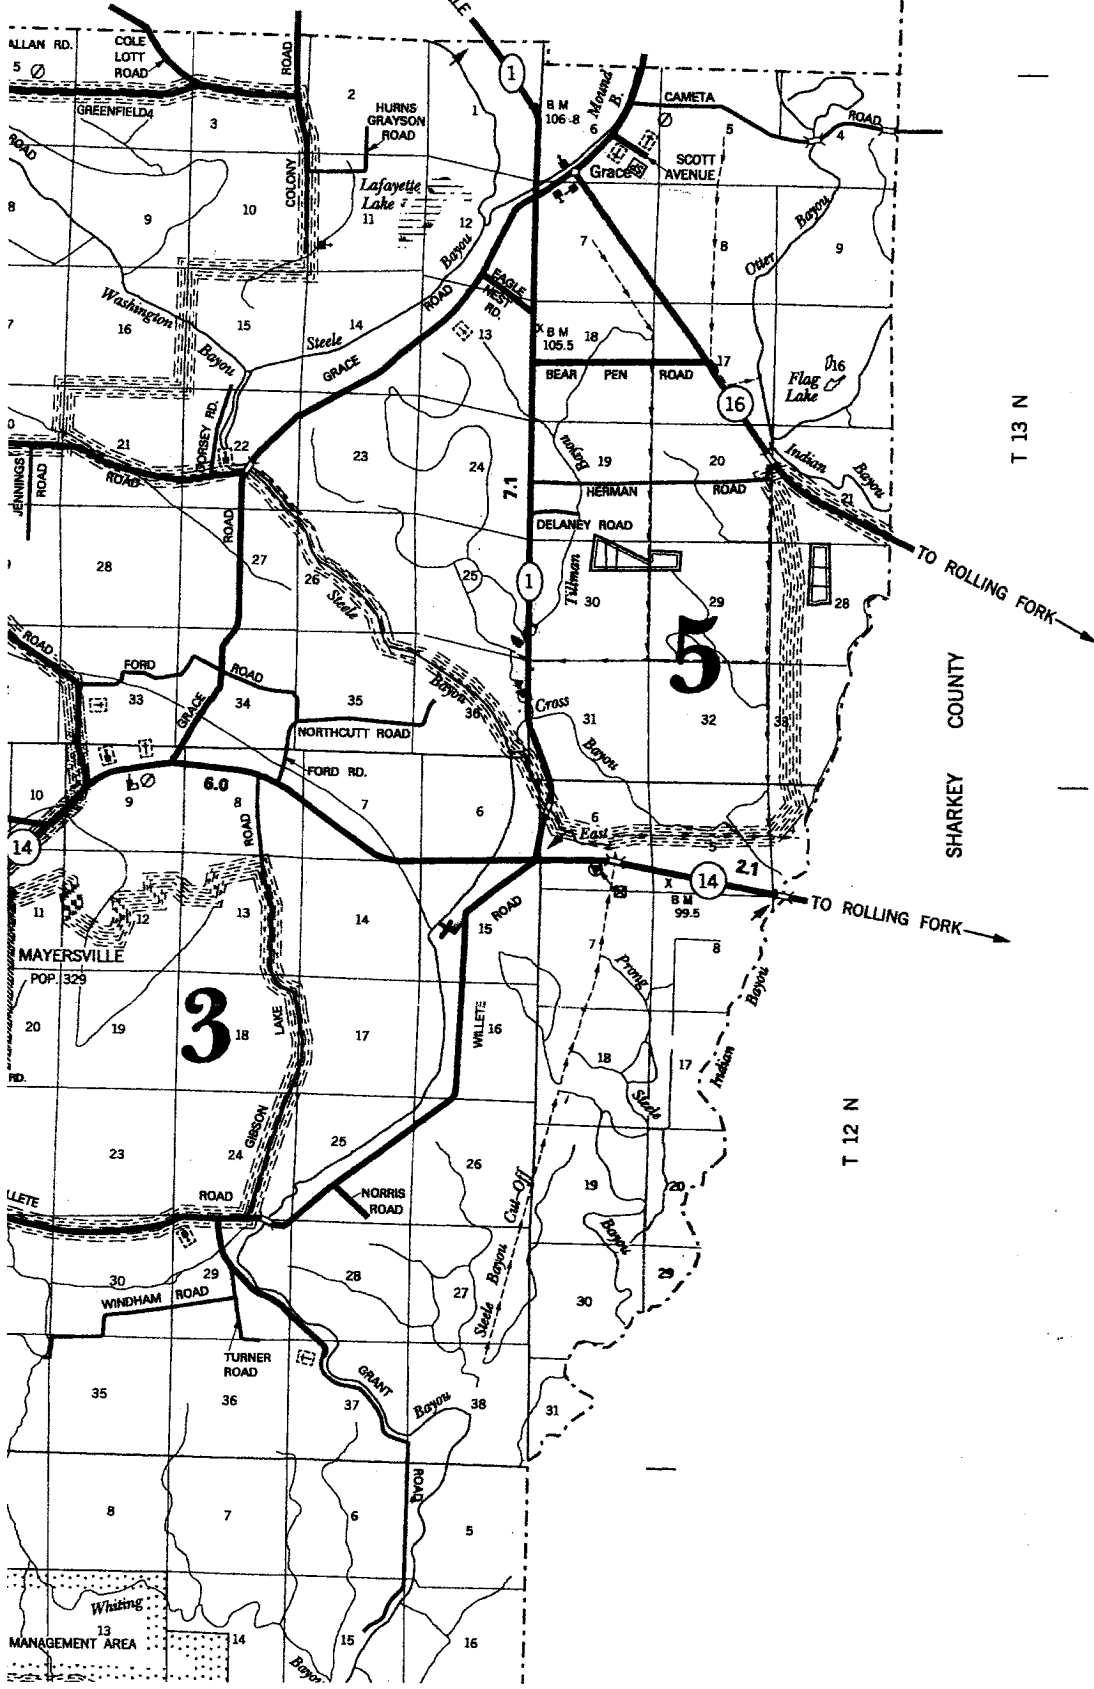

T 13 N

SHARKEY COUNTY

T 12 N

RECEIVED

MAR 15 2013

BY: OLWR