-	m
$-\iota$	

Nima 10"	#4
193	
County: 1550900000 Permit #: 6W-50757	7
Driller: J. Newcome o.	773
Date drilling completed: 4/2-2	1/9

STATE WELL REPORT

Part 1


Driller's Log
Mississippi Department of Environmental Quality Office of Land and Water Resources P.O. Box 2309 Jackson, MS 39225-2309

(601)961-5555 (601)961-5228 (fax)

For O	B 102
Well #:	B 102
Aquifer:	
E-Log #:	

State Law requires that this report be prepared by the license holder responsible for the work and filed with the Department at the above address within 30 days of completion of drilling of the well or borehole,

Department at the areas	Weil or Borehole Location
Well Owner Information (Landowner if borehole is not for a water well)	Latitude: 32 55 02 Longitude: 91 00 17
Owner Name: Napper Form Partnership	Method of Lat/Long (check one): Conventional Survey,
Mailing Address: 67 Plantation Orice	USGS quad, Hand-held GPS, Survey-grade GPS
R-11: FUK MS 39159	SW 14 NE 14, Sec 8 T 12N R 8W
Rolling Fork MS 39159 City State Zip Code	(Distance) (Direction) (Nearest Town)
Telephone No. ()	
Well /	Borehole Data 1:1-23-19 Hole depth: 10 3 Hole diameter: 20
Location of the source of any surface water used for drill	ing: Ditch
Location of the source of any surface water used for diffe	and development:
Method of dosing and volume of Chlorine used in drilling	and development.
Logs run (check all applicable): Gog run Electric Gan	nma Ray Density Donic Livertroit
Name of organization running log(s):	
Purpose of borehole (check one); Water Well Geotech	nical/Geological Investigation Ground Source Heat Pump
Seismic Survey Othe	r (describe)
If drilling is not related to water well	construction, skip the remainder of this block
Purpose of Well (check all applicable): Home Indust	rial Public Supply Virrigation Fish Culture
Other (describe):	Other (deteribe)
If a flowing well, method of flow regulation: Valve	Other (destribe)
Static Water Level:feethbove_or b (check one)	
Method of measurement (check one) Steel tape Elect	ric tape Air (ine_Other (describe):
Wall depth: 100 Well grouted to a depth of: 10	feet Type of grout (check one) Linear cement Described
Casing length: O feet Casing diameter:	inches Type of Casing.
Screen length:	inches Type of screen.
Screen slot size: 0.50 inches Setting dep	oth: From
Type of completion (check all applicable) Travel packet	d Underreamed Open hole Natural Development
Other (describe):	
1 Tan of the pipe of require tion in Labitati	et
If telescoped or more the	an one screen, describe on next page

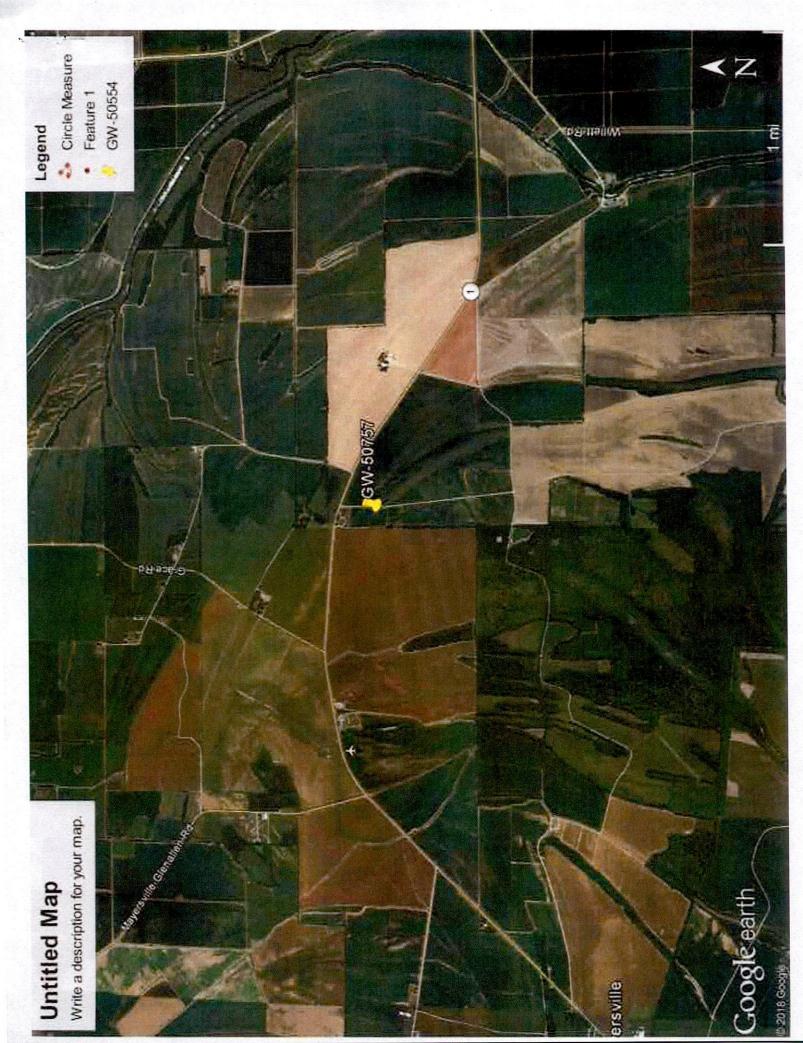

Permit # GW-50757 Permit # GW-50757 Driller: J. Newcome Office of L. Date completed (0 20-19 Copy information from block on Part) (60)	WELL REPORT Part 2 ller's Completion Report tment of Environmental Quality and and Water Resources P.O. Box 2309 kson, MS 39225 601)961-5210 1)961-5228 (fax)	For Office Use Only: Aquifer: Weil #: B 102 Elevation
This part of the report must be completed by a licensed water we report must be attached and both parts filed with the Department Well Owner Information Owner Name: Name: Name: Part ocish D Mailing Address (27 Plants For Direct Ration Fork MS 39159 City O State Zip Code Telephone No. (Latitude: 32 55 62 Method of Lat/Long (check or USGS quad, Hand-held	Longitude: 91 00 1 7 Conventional Survey GPS X. Survey-grade GPS T 12 N R 8 N
Air Lift Jet Submersible Bucket Piston Turbine Centrifugal Rotary Flowing Well Other (specify): Date Pump Installed: 4130/9 Rated Pump Capacity: 1200 Gallons Per Minute	Diesel Engine Gasoline Efectric Motor Hand	
Pump Test Data Date Well Tested: Static Water Devel (A). Feet Below Land Surface Pumping Water Devel (B). Feet Below Land Surface Drawdown [(B) – (A). Feet Below Land Surface Feet Below Land Surface Gallons Per Minute Duration of Pump Test (minimum 4 bours): hours	Other (specify): For flowing well, measured shut Well yielded	
This is for (circle one): New Well Replacement of Ex HEREBY CERTIFY that the above statements are true to the best		ting Pump

Hubbard Stephens P 741
Print Name of Pump Installer and License No. (if applicable)

Signature of Pump Installer
Form: OLWR-SWR-1C (07-09)