


C 11
4-4-61

WATER WELL DRILLERS LOG

C 11
ISSAQUENA
CODED

Date: APR. 4, 1961, Driller: DELTA DRILLING Co. County: LEFFLER
(Name)

(1) Owner of Land: <u>D. W. FULTON</u> <u>MRS. IRENE W. WELLS</u> (Name)	Description & Color of Materials Sand, Clay, Red Clay, Shell, etc.	Thick- ness Feet	Depth Feet
<u>MAYERSVILLE, MISS.</u> (Address)	SAND + SHALE MIXED	22	22
(2) Location: <u>NE</u> <u>SW 1/4</u> , <u>SW 1/4</u> , Sec. <u>15</u> T. <u>9E</u>	SHALE	22	64
_____ miles _____, of _____ (distance) (direction) (Nearest Town)	SAND	43	107
(3) Topography: _____ (Hilly) (Flat) (Level)	GRAVEL	48	155
(4) Purpose of Well: <u>DOMESTIC</u> (Domestic Irrigation Municipal, Industrial, Other)	SAND	12	167
Information upon completion of well:	SHALE	38	205
(1) Diameter <u>3</u> inches.	SAND	40	245
(2) Total Depth <u>1086</u> feet.	SHALE	95	340
(3) Water Level _____ feet below top of ground.	SAND	108	448
(4) Cased to <u>1086'</u> , Size <u>2" - 919</u>	SHALE W/7" ROCK	42	490
(5) Screen: Size <u>2"</u> , Length <u>20'</u>	SAND W/3" ROCK	41	531
(6) Were any formations sealed against pollution? _____ yes, _____ no.	SHALE	8	539
If YES depth of formation _____	SHALE SAND	42	581
Why _____	GUMBO	46	627
Drillers Remarks: _____	SHALE	38	665
COMPLETE ELEC LOG MADE BY <u>U.S.G.S.</u>	GUMBO	26	691
	SAND W/SHALE STREAKS	49	740
	SHALE	10	750
	SAND	26	776
	SHALE W/5" ROCK	46	822
	FINE SAND	41	863
	SAND + SHALE MIXED	86	949
	SAND (FINE)	104	1053
	WHITE SAND	33	1086

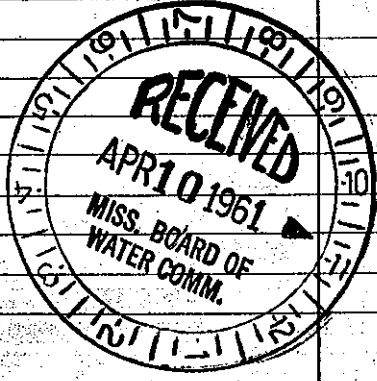

Well No.

(Use Back Side)