

C 18

12-21-65


WATER WELL DRILLERS LOG

Date: 12/21, 1965, Driller: Bailey Drilling Co (Name)

County: **CODED** (Large stamp)

(1) Owner of Land:	Description & Color of Materials Sand, Clay, Red Clay, Shell, etc.	Thick- ness Feet	Depth Feet
Walter Heigle (Name) Tallula, Miss. (Address)	Clay		20
	Sand		82
	Gravel		123
(2) Location: 1/4, 1/4, Sec. 14 T11R9	Mud		471
of Tallula (distance) miles (direction) of (Nearest Town)	Sand		510
(3) Topography: Flat (Hilly) (Flat) (Level)	Mud		560
(4) Purpose of Well: Domestic (Domestic Irrigation Municipal, Industrial, Other)	Rocks		588
	Mud		680
	Rocks		682
	Mud		688
	Rocks		689
	Mud		711
Information upon completion of well:	Rock		712
(1) Diameter 4x2 1/2 x 2 inches	Mud		720
(2) Total Depth 1111 feet	Rocks		721
(3) Water Level 12 feet below top of ground	Mud		728
(4) Cased all way size 4x2 1/2 x 2	Rock		729
(5) Screen: Size 2", Length 20ft	Mud		800
(6) Were any formations sealed against pollution?	Rock		801
yes, <input checked="" type="checkbox"/> no.	Mud		1005
If YES depth of formation	Rock		1006
Why	Mud		1011
Drillers Remarks:	Sand & mud		1057
	Sand		1111

CODED (Large stamp)

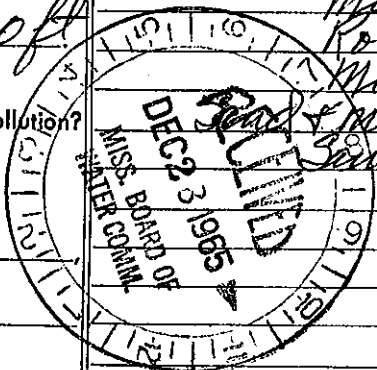

(Use Back Side)

Well No.