

Issaquena
C 26
8-66

MISSISSIPPI BOARD OF WATER COMMISSIONERS

WATER WELL DRILLERS LOG

COD-7 ISSaquena

Date: 8-22, 1966, Driller: Butane Gas Co. of Greenwood County Leban
(Name)


| (1) Owner of Land: <u>Homer Small</u> (Name) | Description & Color of Materials Sand, Clay, Red Clay, Shell, etc. | Thick- ness Feet | Depth Feet |
|--|---|------------------------|---------------|
| <u>Rolling Fork, Miss.</u> (Address) | Clay | 13 | 13 |
| | " | 10 | 23 |
| (2) Location: <u>SW 1/4, NE 1/4, Sec. 13 T11R9W</u> | Fine Sand | 10 | 33 |
| <u>1</u> miles <u>N</u> , of <u>Jaculla</u> (distance) (direction) (Nearest Town) | " | 10 | 43 |
| (3) Topography: <u>Flat</u> (Hilly) (Flat) (Level) | " | 10 | 53 |
| (4) Purpose of Well: <u>Irrigation</u> (Domestic, Irrigation, Municipal, Industrial, Other) | Med. Sand | 10 | 73 |
| | Coarse Sand - Gravel | 10 | 83 |
| | " | 10 | 93 |
| | " | 10 | 103 |
| | " | 10 | 113 |

Information upon completion of well:

- (1) Diameter 16 inches.
- (2) Total Depth 113 feet.
- (3) Water Level 11 feet below top of ground.
- (4) Cased to 93, Size 16
- (5) Screen: Size 16, Length 40
- (6) Were any formations sealed against pollution?
_____ yes, X no.

If YES depth of formation _____
Why _____
Drillers Remarks: _____

CODED

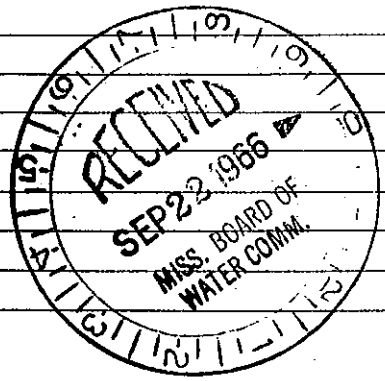

(Use Back Side)

Well No.

Mail this copy to Board of Water Commissioners 429 Miss. St. Jackson, Miss.