

Issaquena
C 28
10-13-75

**MISSISSIPPI
 BOARD OF WATER COMMISSIONERS
 416 North State Street
 Jackson, Mississippi 39201
 WATER WELL DRILLERS LOG**

October 13, 1975 Singer-Layne Central Issaquena
 date well completed firm name county well located


LANDOWNER: <u>James Mabus</u> <u>Mayersville, Ms</u> (mailing address)	description of formations encountered	from	to
	Fine Sand	28	40'
	Coarse Sand	40	65'
	Coarse Sand Gravel	65	121'
	Clay	121	122'

WELL LOCATION:
sec. 12 T. 11 N R. 8 W ¹⁵¹
4.6 miles South of Mayersville
 (distance) (direction) (nearest town)

WELL PURPOSE: irrigation
 (home, irrigation, municipal, industrial)

- WELL COMPLETION DATA:**
- (1) diameter (inches) 16"
 - (2) total depth (feet) 122'
 - (3) static water level (feet) 12 below above
top of ground.
 - (4) casing Steel, 62'
(material) (depth)
16"
(size) if telescope see back.
 - (5) screen 60', 62'
(length) (depth to top)
16" Steel
(size) (material)
 - (6) pump 60 2800-3000
(HP) (yield gpm)
Engine
(type power)
 - (7) electric log no
(yes or no)
(organization running log)
 - (8) how well bottom plugged steel plate

DRILLERS REMARKS:

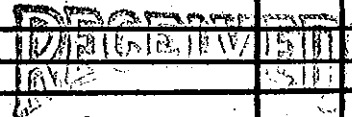

OCT 28 1975

Miss. D. COMM