

ISSAQUENA

MISSISSIPPI BOARD OF WATER COMMISSIONERS

D13

12-23-65

WATER WELL DRILLERS LOG

1/17/66
CODED 70

Date: Dec. 23, 1965, Driller: Layne-Central Company County Issaquena

303 297

(Name)

(1) Owner of Land: **Darden Company**

(Name)

Onward, Mississippi

(Address)

(2) Location: 1/4, 1/4, Sec. **7, 8, 25 T10 R 8**,

2 1/2 miles **west** of **Onward**
(distance) (direction) (Nearest Town)

(3) Topography: **flat**

(Hilly) (Flat) (Level)

(4) Purpose of Well: **irrigation**

(Domestic Irrigation
Municipal, Industrial, Other)

Description & Color of Materials
Sand, Clay, Red Clay, Shell, etc.

Thick-
ness
Feet

Depth
Feet

Clay

3

3

Sand

5

8

Clay

57

65

Coarse sand

10

75

Coarse sand, pea gravel

45

120

Clay

120

Information upon completion of well:

(1) Diameter **12** inches.

(2) Total Depth **120** feet.

(3) Water Level **16' 7"** feet below top of ground.

(4) Cased to **72'**, Size **12"**

(5) Screen: Size **12"**, Length **50'**

(6) Were any formations sealed against pollution?


yes, **no** no.

If YES depth of formation _____

Why _____

Drillers Remarks: _____

CODED

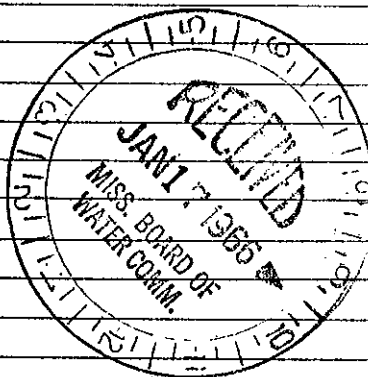

Well No.

(Use Back Side)

Mail this copy to Board of Water Commissioners 429 Miss. St. Jackson, Miss.