

Well #1

Issaquena
D24
5-1-81

MISSISSIPPI
BOARD OF WATER COMMISSIONERS
416 North State Street
Jackson, Mississippi 39201
CODED
WATER WELL DRILLERS LOG

5-1-81 19 81 Drilling & Associates Issaquena
date well completed firm name county well located

LANDOWNER: Herchel Teems
P.O. Box 43
Rolling Fork, MS 39159
(mailing address)

WELL LOCATION:
sec. 12 T. 10 N R. 8 E
S W of ONWARD
(distance) (direction) (nearest town)


WELL PURPOSE: Irrigation
(home, irrigation, municipal, industrial)

WELL COMPLETION DATA:

- (1) diameter (inches) 16"
- (2) total depth (feet) 115'
- (3) static water level (feet) 22' below top of ground. above
- (4) casing steel 75'
(material) (depth)
16"
(size) If telescope see back.
- (5) screen 40' 75'
(length) (depth to top)
16" steel
(size) (material)
- (6) pump 60 3800
(HP) (yield gpm)
Deisel
(type power)
- (7) electric log No
(yes or no)
No
(organization running log)
- (8) how well bottom plugged steel
plug

description of formations encountered	from	to
Top soil	0	5
Brown clay	5	10
Brown clay	10	15
Brown clay	15	20
Brown clay	20	25
Brown clay	25	30
Blue clay	30	35
Blue clay & fine sand	35	40
Clay & fine sand	40	45
fine sand	45	50
Blue clay	50	55
Blue clay & fine sand	55	60
Fine sand & clay	60	65
Fine sand	65	70
Fine sand	70	75
Fine sand	75	80
Fine & Med. sand	80	85
Fine sand	85	90
Course sand & gravel	90	95
Course sand & gravel	95	100
Course sand & gravel	100	105
Course sand & gravel	105	105
Bottom of Hole	105	105

CODED

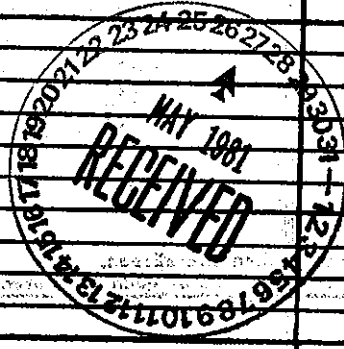

DRILLERS REMARKS: