

Tasqueena  
D26  
5-1-81

MISSISSIPPI  
 BOARD OF WATER COMMISSIONERS  
 416 North State Street  
 Jackson, Mississippi 39201

CODED

WATER WELL DRILLERS LOG

5-1 1981 Drelling & Associates Tasqueena  
 date well completed firm name county well located

LANDOWNER: Hershal Toombs

P.O. Box 43

Rolling Fork, MS 39159  
 (mailing address)

WELL LOCATION:


sec 11 T 10 N R 2 E  
7 miles W of ONWARD  
 (distance) (direction) (nearest town)

WELL PURPOSE: irrigation  
 (home, irrigation, municipal, industrial)

WELL COMPLETION DATA:

- (1) diameter (inches) 10"
- (2) total depth (feet) 114'
- (3) static water level (feet) 22' <sup>below</sup> <sub>above</sub> top of ground.
- (4) casing plastic 86'  
 (material) (depth)  
10" if telescope see back.  
 (size)
- (5) screen 30' 86'  
 (length) (depth to top)  
10" plastic  
 (size) (material)
- (6) pump 30 1500  
 (HP) (yield gpm)  
electric  
 (type power)
- (7) electric log no  
 (yes or no)  
no  
 (organization running log)
- (8) how well bottom plugged steel  
plug

description of formations encountered	from	to
Top soil	0	5
Brown clay	5	10
Brown clay	10	15
Clay & fine sand	15	20
Fine sand	20	25
Fine & Med. sand	25	30
Clay & Med. sand	30	35
Med. sand	35	40
Med. & course sand	40	45
Med. sand & gravel	45	50
Course sand-small gravel	50	52 55
Course sand & gravel	55	60
Course sand & gravel	60	65
Course sand & gravel	65	70
Med. sand & gravel	70	73 75
Med. sand & gravel	75	80
Med. sand & gravel	80	85
Med. & fine sand	85	90
Med. & fine sand	90	95
Course sand & gravel	95	100
Course sand & gravel	100	106
Fine sand	106	108
Course sand & gravel	108	112
Clay	112	114
Bottom of hole	CODED	

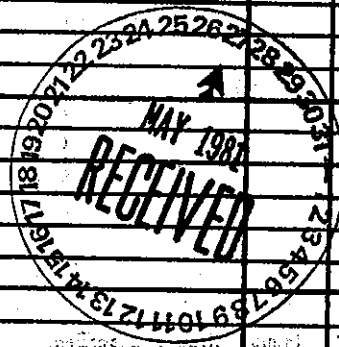

DRILLERS REMARKS: