

DEQ


MISSISSIPPI DEPARTMENT OF ENVIRONMENTAL QUALITY
Office of Land and Water Resources
P. O. Box 2309
Jackson, MS 39225
Water Well Plugging/Decommissioning Form
OLWR-DF-1 (04/08)

COUNTY WELL LOCATED:	Issaquena	WELL NUMBER:	D29
PERMIT NUMBER:	GW-03662	DATE WELL PLUGGED:	9-14-2019
NAME OF FIRM PLUGGING WELL:	Irrigation Equipment Inc.	TELEPHONE NUMBER:	662-887-2555
NAME AND ADDRESS OF CURRENT LANDOWNER:	Derr Plantation 47 Fidler Road Rolling Fork MS 39159		
WELL LOCATION:	SECTION: 13	TOWNSHIP: 10N	RANGE: 8W
WELL LOCATION: LATITUDE:	32 43 30.4	LONGITUDE:	90 59 11.1
METHOD (CIRCLE ONE): (1) USGS QUAD (2) CONVENTIONAL SURVEY (3) GPS - HAND HELD OR SURVEY GRADE			
DISTANCE:	DIRECTION:	NEAREST TOWN: Fidler	OTHER LANDMARK:
WELL PURPOSE (HOME, IRRIGATION, MUNICIPAL, ETC.):	Irrigation		
NAME OF WELL CONTRACTOR WHO DRILLED THE WELL:			
NAME OF LANDOWNER WHEN WELL WAS DRILLED:			


WELL DATA			
WELL DEPTH:	77Ft. 110	HOLE DEPTH:	
CASING DIAMETER (IN.):	12	CASING LENGTH (FT.):	
		TYPE OF CASING:	Steel
DEPTH TO STATIC WATER LEVEL:	11Ft.	DATE WELL COMPLETED:	
WHY IS THE WELL BEING ABANDONED?	Replaced		

Depth was mixed up with D27 which was plugged at same time.

DESCRIBE HOW THE WELL OR HOLE WAS PLUGGED (AMOUNT OF CASING AND/OR SCREEN THAT WAS REMOVED OR LEFT IN HOLE, MATERIAL AND AMOUNT USED IN PLUGGING, METHOD OF PLACING MATERIAL, ETC.)
Removed casing below ground level. Installed 5% chlorine bleach. Installed sand and gravel.
Installed 1000 pounds of bentonite hole plug.
New Well Drilled: GW-50941

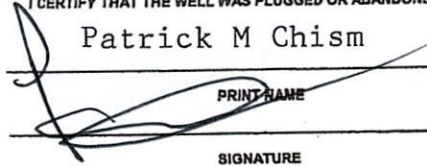I CERTIFY THAT THE WELL WAS PLUGGED OR ABANDONED IN ACCORDANCE WITH THE STATE OF MISSISSIPPI REGULATIONS.	
Patrick M Chism	0695
	MS LICENSE NUMBER
PRINT NAME	10-14-2019
SIGNATURE	DATE

RECEIVED
OCT 20 2019
BY OLWR

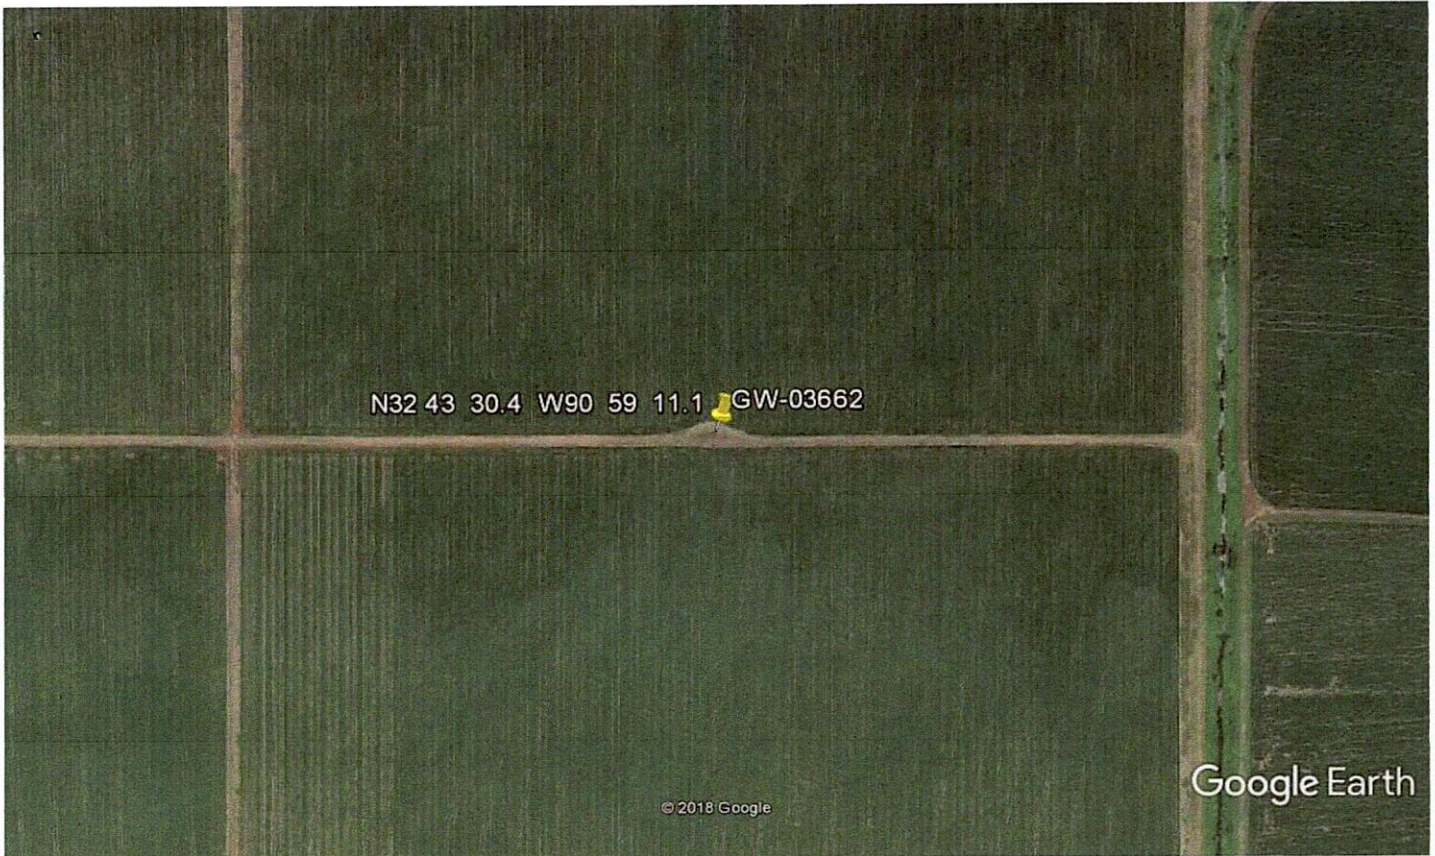

Google Earth



RECEIVED
OCT 20 2019
BY OLWR