

Issaquena
E 8
4-67

MISSISSIPPI
BOARD OF WATER COMMISSIONERS
416 North State Street
Jackson, Mississippi 39201

WATER WELL DRILLERS LOG

4-25 1967 Rolling Fork Machine Shop Issaquena
date well completed firm name county well located

LANDOWNER: R. Tremaine

Rt. 4 Box 439

Vicksburg, Miss.
(mailing address)

WELL LOCATION:

sec. 1 T. 9 N R. 8 W
5 miles NE of Chotard
(distance) (direction) (nearest town)

WELL PURPOSE: Home
(home, irrigation, municipal, industrial)

WELL COMPLETION DATA:


- (1) diameter (inches) 2"
- (2) total depth (feet) 94'
- (3) static water level (feet) 12 below top of ground.
- (4) casing G. Pipe 91
(material) (depth)
(size) if telescope see back.
- (5) screen 3' 91
(length) (depth to top)
2" Monel
(size) (material)
- (6) pump 1/2 5
(HP) (yield gpm)
Electric
(type power)
- (7) electric log No
(yes or no)
(organization running log)
- (8) how well bottom plugged
Check Valve

description of formations encountered

from to

Sandy Loam	0	22
Fine Sand	22	84
Sand & Gravel	84	94

COPIED

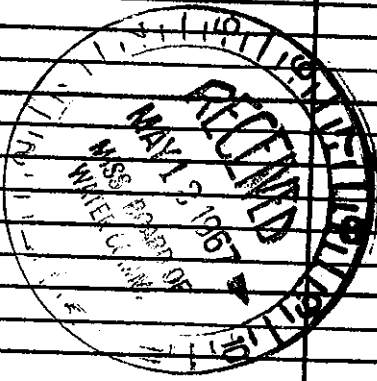

DRILLERS REMARKS: