

102

G 2


10-20-61

WATER WELL DRILLERS LOG

CODED

Date: OCT 20, 1961, Driller: DELTA DRILLING Co. County: ISSAQUENA
(Name)

		Description & Color of Materials Sand, Clay, Red Clay, Shell, etc.	Thick- ness Feet	Depth Feet
(1) Owner of Land: <u>DR G. L. JOHNSON</u> (Name)		<u>GUMBO</u>	<u>30</u>	<u>30</u>
<u>VALLEY PARK, MISS</u> (Address)		<u>SAND</u>	<u>32</u>	<u>62</u>
(2) Location: <u>1/4, 1/4, Sec. 18 T9 R6</u>		<u>GRAVEL</u>	<u>80</u>	<u>142</u>
<u>1/2</u> miles <u>SOUTH</u> , of <u>VALLEY PARK</u> (distance) (direction) (Nearest Town)		<u>GUMBO</u>	<u>480</u>	<u>622</u>
(3) Topography: _____ (Hilly) (Flat) (Level)		<u>SAND</u>	<u>18</u>	<u>640</u>
(4) Purpose of Well: <u>DOMESTIC</u> (Domestic Irrigation Municipal, Industrial, Other)		<u>SHALE</u>	<u>15</u>	<u>655</u>
Information upon completion of well:		<u>GUMBO W/3" ROCK</u>	<u>30</u>	<u>685</u>
(1) Diameter <u>4 1/2</u> inches.		<u>SHALE</u>	<u>14</u>	<u>699</u>
(2) Total Depth <u>1480</u> feet.		<u>SAND</u>	<u>84</u>	<u>783</u>
(3) Water Level _____ feet below top of ground.		<u>SHALE W/SAND STREAKS</u>	<u>66</u>	<u>849</u>
(4) Cased to <u>1480'</u> , Size <u>4 x 2"</u>		<u>SAND</u>	<u>88</u>	<u>937</u>
(5) Screen: Size <u>2</u> , Length <u>20'</u>		<u>SHALE</u>	<u>23</u>	<u>960</u>
(6) Were any formations sealed against pollution? _____ yes, _____ no.		<u>SAND</u>	<u>33</u>	<u>993</u>
If YES depth of formation _____		<u>GUMBO + SHALE MIXED -</u>	<u>20</u>	<u>1013</u>
Why _____		<u>SHALE W/3" ROCK</u>	<u>18</u>	<u>1031</u>
Drillers Remarks: <u>22' LAP OF 2" IN 3"</u>		<u>GUMBO + SHALE MIXED -</u>	<u>41</u>	<u>1072</u>
<u>PIPE</u>		<u>SHALE W/5" ROCK -</u>	<u>58</u>	<u>1130</u>
		<u>GUMBO</u>	<u>20</u>	<u>1150</u>
		<u>SHALE W/6" ROCK - 118'</u>	<u>114</u>	<u>1264</u>
		<u>SAND</u>	<u>44</u>	<u>1308</u>
		<u>SHALE</u>	<u>30</u>	<u>1338</u>
		<u>SAND</u>	<u>12</u>	<u>1350</u>
		<u>SHALE</u>	<u>38</u>	<u>1388</u>
		<u>SAND</u>	<u>92</u>	<u>1480</u>

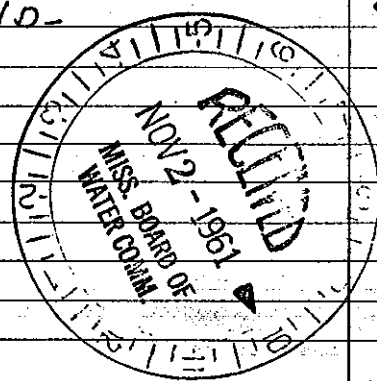

(Use Back Side)

Well No.