


ISSAQUENA
F 23

MISSISSIPPI CODED
BOARD OF WATER COMMISSIONER
416 North State Street
Jackson, Mississippi 39201

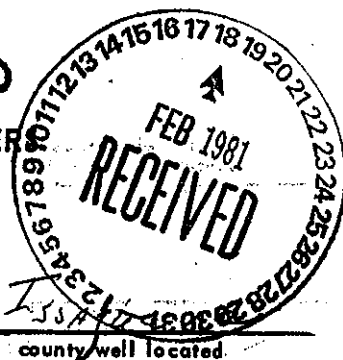

WATER WELL DRILLERS LOG

2/16/81
Feb. 6 1981 E.M. "Bud" Cresswell Issaquena
date well completed firm name county/well located.

LANDOWNER:
Ms. Grain Service
Valley Park, MS.
(mailing address)

description of formations encountered	from to	
Clay	0	30
Sand-grump	30	140

WELL LOCATION:
sec. 13 T. 9 N R. 7 E
1 miles South of Valley Park
(distance) (direction) (nearest town)

WELL PURPOSE: Industrial
(home, irrigation, municipal, industrial)

- WELL COMPLETION DATA:
- (1) diameter (inches) 4
 - (2) total depth (feet) 140
 - (3) static water level (feet) 22 below top of ground.
 - (4) casing PVC 100 (material) (depth)
4 (size) 1/2 telescope see back.
 - (5) screen 40 100 (length) (depth to top)
4 PVC (size) (material)
 - (6) pump 5 80 (HP) (yield gpm)
(type power)
 - (7) electric log No (yes or no)
 - (organization running log)
 - (8) how well bottom plugged
Back with valve

DRILLERS REMARKS:

