


ISSAQUENA
FJA
1/28/81
1-28-81

CODED

MISSISSIPPI
BOARD OF WATER COMMISSIONERS
416 North State Street
Jackson, Mississippi 39201

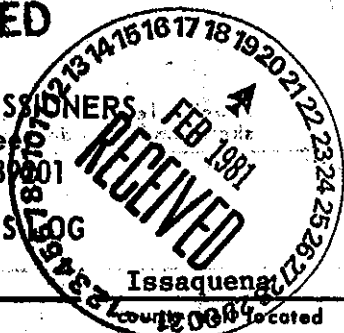

WATER WELL DRILLERS LOG

Dreiling & Associates

Issaquena located

date well completed firm name

LANDOWNER	Description of formations encountered	from	to
Billy & Larry Whitten	Top soil	0	5
Valley Park, MS 39177	clay	5	10
(mailing address)	clay	10	15
WELL LOCATION:	clay	15	20
sec. 26 T 9 ^(N) R 7 ^(E)	clay	20	25
2 miles W of Valley Park	clay	25	30
(distance) (direction) (nearest town)	clay blue	30	35
WELL PURPOSE: irrigation	clay blue	35	40
(home, irrigation, municipal, industrial)	blue & brown clay	40	45
WELL COMPLETION DATA:	clay & brown clay	45	50
(1) diameter (inches) 26"	clay & gravel	50	55
(2) total depth (feet) 100'	big gravel & sand	55	60
(3) static water level (feet) 12' ^{below} _{above} top of ground.	big gravel & sand	60	65
(4) casing steel 80' (material) (depth)	big gravel & sand	65	70
(size) If telescope see back.	big gravel & sand	70	75
(5) screen 20' 80' (length) (depth to top)	big gravel & sand	75	80
16" steel (size) (material)	big gravel & sand	80	85
(6) pump 75 1200 (HP) (yield gpm)	big gravel & sand	85	90
diesel (type power)	big gravel & sand	90	95
(7) electric log no (yes or no)	big gravel & sand	95	100
(organization running log)			
(8) how well bottom plugged steel plug			
DRILLERS REMARKS:			

DEPT. OF NATURAL RESOURCES
BUREAU OF LAND & WATER RESOURCES

FEB 20 1981

RECEIVED