

ISSAQUENA MISSISSIPPI BOARD OF WATER COMMISSIONERS

68

8-29-63


WATER WELL DRILLERS LOG

Date: 8-29, 1963, Driller: David Penny County: 132 67

(Name)

CODED

(1) Owner of Land:	Description & Color of Materials Sand, Clay, Red Clay, Shell, etc.	Thick- ness Feet	Depth Feet
<u>L. S. Braxton, M. S. Ponton,</u> <u>W. F. Cooper, Jr.</u> <u>D. S. Johnson</u> <u>Valley Park, Miss.</u>	Clay	20	20
(2) Location: $\frac{1}{4}$, $\frac{1}{4}$, Sec. $\frac{7}{8}$ T. 9 R. 6	Sand	60	80
_____ miles _____ of _____	Sand	20	100
(3) Topography: <u>Flat</u>	Sand & gravel	60	160
(4) Purpose of Well: <u>Domestic</u>	Brown clay	80	240
_____ (Hilly) _____ (Flat) _____ (Level)	Shale	120	360
(4) Purpose of Well: <u>Domestic</u>	Sand	60	420
_____ (Domestic Irrigation Municipal, Industrial, Other)	Shale	80	500
Information upon completion of well:	Gumbo	110	600
(1) Diameter <u>4 1/2</u> inches.	Shale	180	780
(2) Total Depth <u>1450</u> feet.	Sand	180	960
(3) Water Level <u>blowing</u> feet below top of ground.	Shale	60	1020
(4) Cased to <u>200'</u> , Size <u>4"</u>	Gumbo	120	1140
(5) Screen: Size <u>2"</u> , Length <u>40'</u>	Sand & gumbo	60	1200
(6) Were any formations sealed against pollution?	Gumbo	40	1240
_____ yes, _____ no.	Sand	40	1280
If YES depth of formation _____	Gumbo	20	1300
Why _____	Sand	40	1340
Drillers Remarks: _____	Clay	40	1380
_____	Sand	90	1450
_____	_____	_____	_____
_____	_____	_____	_____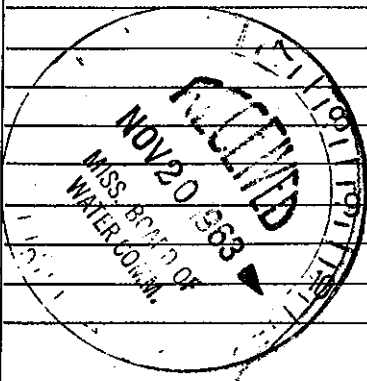
(Use Back Side)

Well No.

Mail this copy to Board of Water Commissioners 429 Miss. St. Jackson, Miss.