


MISSISSIPPI DEPARTMENT OF ENVIRONMENTAL QUALITY
Office of Land and Water Resources
 P. O. Box 2309
 Jackson, MS 39225
Water Well Plugging/Decommissioning Form
 OLWR-DF-1 (04/08)


COUNTY WELL LOCATED: Issaquena		WELL NUMBER: C55H15	
PERMIT NUMBER: GW-16030		DATE WELL PLUGGED: 9-13-2018	
NAME OF FIRM PLUGGING WELL: Irrigation Equipment Inc.		TELEPHONE NUMBER: 662-887-2555	
NAME AND ADDRESS OF CURRENT LANDOWNER: MDWFP-Mahannah WMA 1370 Anderson-Tully Rd Redwood MS 39156		601-661-0294	
WELL LOCATION: SECTION: 9		TOWNSHIP: 18N RANGE: 3E	
WELL LOCATION: LATITUDE: 32° 33 32.5		LONGITUDE: 90° 55 06.9	
METHOD (CIRCLE ONE): (1) USGS QUAD (2) CONVENTIONAL SURVEY (3) GPS - HAND HELD OR SURVEY GRADE			
DISTANCE:		DIRECTION:	
		NEAREST TOWN: Redwood	
		OTHER LANDMARK:	
WELL PURPOSE (HOME, IRRIGATION, MUNICIPAL, ETC.): Wildlife Management			
NAME OF WELL CONTRACTOR WHO DRILLED THE WELL:			
NAME OF LANDOWNER WHEN WELL WAS DRILLED:			

WELL DATA			
WELL DEPTH: 125ft.		HOLE DEPTH:	
CASING DIAMETER (IN.): 16	CASING LENGTH (FT.):	TYPE OF CASING: PVC	
DEPTH TO STATIC WATER LEVEL: 10ft.		DATE WELL COMPLETED:	
WHY IS THE WELL BEING ABANDONED? Replaced			

DESCRIBE HOW THE WELL OR HOLE WAS PLUGGED (AMOUNT OF CASING AND/OR SCREEN THAT WAS REMOVED OR LEFT IN HOLE, MATERIAL AND AMOUNT USED IN PLUGGING, METHOD OF PLACING MATERIAL, ETC.) Removed casing below ground level. Installed 5% chlorine bleach. Installed sand and gravel. Installed bentonite hole plug. New Well: 32° 33 32.9 90° 55 06.9

RECEIVED
DEC 20 2018
BY OLWR

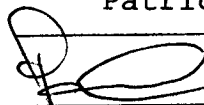I CERTIFY THAT THE WELL WAS PLUGGED OR ABANDONED IN ACCORDANCE WITH THE STATE OF MISSISSIPPI REGULATIONS.	
Patrick M Chism	0695
	MS LICENSE NUMBER
PRINT NAME	11-7-2018
SIGNATURE	DATE

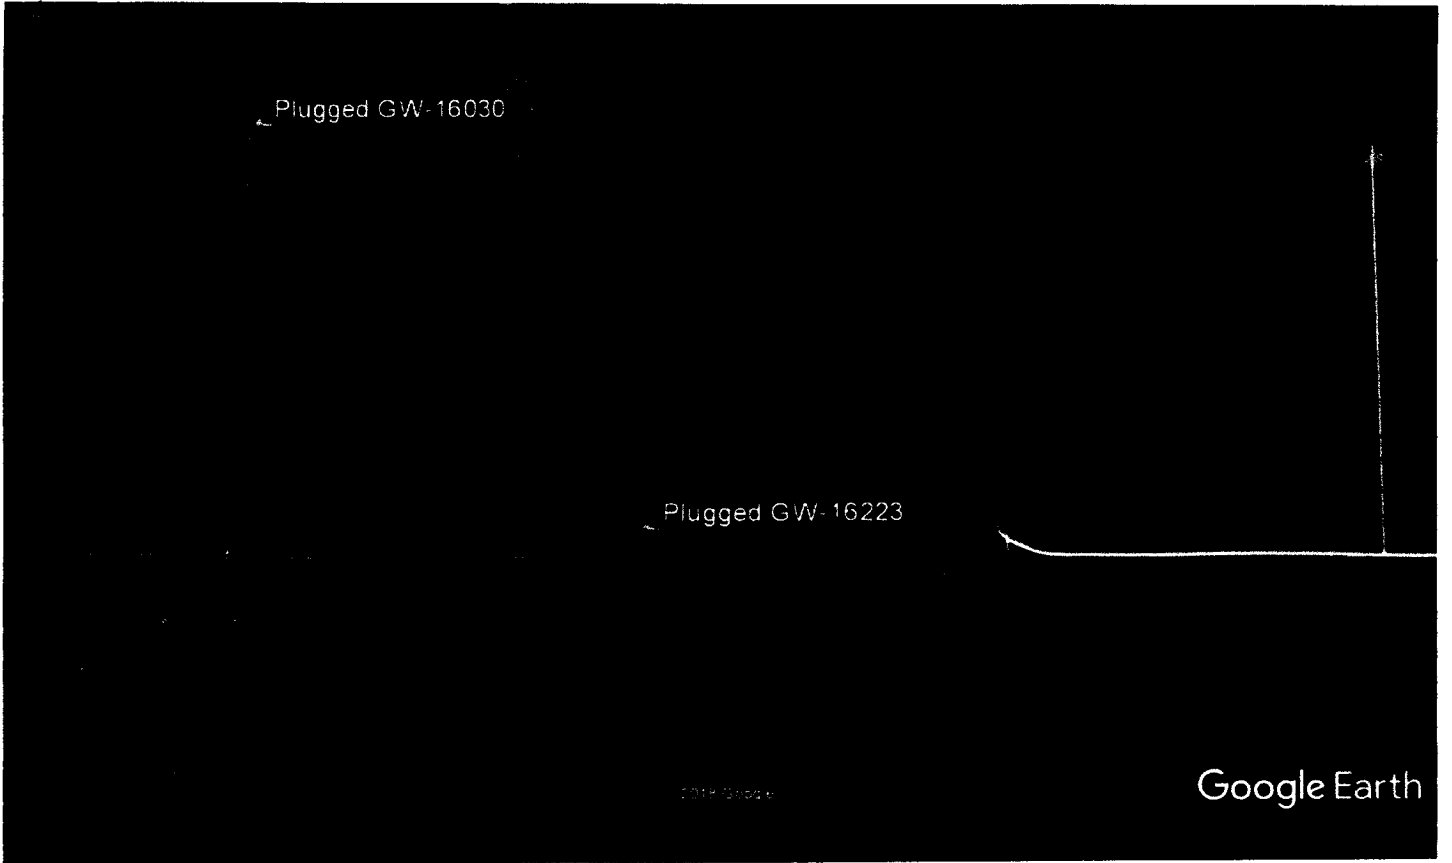

Plugged GW-16030

Plugged GW-16223

© 2018 Google

Google Earth

Google Earth



RECEIVED
DEC 20 2018
BY OLWP