


**MISSISSIPPI DEPARTMENT OF ENVIRONMENTAL QUALITY**  
**Office of Land and Water Resources**  
P. O. Box 2309  
Jackson, MS 39225  
**Water Well Plugging/Decommissioning Form**  
OLWR-DF-1 (04/08)


COUNTY WELL LOCATED: Issaquena		WELL NUMBER: 055 H14	
PERMIT NUMBER: GW-16223		DATE WELL PLUGGED: 9-12-2018	
NAME OF FIRM PLUGGING WELL: Irrigation Equipment Inc.		TELEPHONE NUMBER: 662-887-2555	
NAME AND ADDRESS OF CURRENT LANDOWNER: MDWFP-Mahannah WMA 1370 Anderson-Tully Rd Redwood MS 39156		601-661-0294	
WELL LOCATION: SE/SW	SECTION: 10	TOWNSHIP: 18N	RANGE: 3E
WELL LOCATION: LATITUDE: 32° 32 56.9	LONGITUDE: 90° 54 26.0	METHOD (CIRCLE ONE): (1) USGS QUAD (2) CONVENTIONAL SURVEY (3) GPS - HAND HELD OR SURVEY GRADE	
DISTANCE:	DIRECTION:	NEAREST TOWN: Redwood	OTHER LANDMARK:
WELL PURPOSE (HOME, IRRIGATION, MUNICIPAL, ETC.): Wildlife Management			
NAME OF WELL CONTRACTOR WHO DRILLED THE WELL:			
NAME OF LANDOWNER WHEN WELL WAS DRILLED:			

WELL DATA			
WELL DEPTH: 122ft.	HOLE DEPTH:		
CASING DIAMETER (IN.): 16	CASING LENGTH (FT.):	TYPE OF CASING: PVC	
DEPTH TO STATIC WATER LEVEL: 7ft.	DATE WELL COMPLETED:		
WHY IS THE WELL BEING ABANDONED? Replaced			

DESCRIBE HOW THE WELL OR HOLE WAS PLUGGED (AMOUNT OF CASING AND/OR SCREEN THAT WAS REMOVED OR LEFT IN HOLE, MATERIAL AND AMOUNT USED IN PLUGGING, METHOD OF PLACING MATERIAL, ETC.) Removed casing below ground level. Installed 5% chlorine bleach. Installed sand and gravel. Installed bentonite hole plug.  New Well: 32° 32 56.3 90° 54 26.1
---

RECEIVED  
DEC 20 2018  
BY OLWR

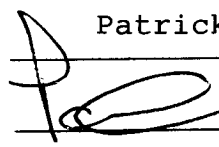I CERTIFY THAT THE WELL WAS PLUGGED OR ABANDONED IN ACCORDANCE WITH THE STATE OF MISSISSIPPI REGULATIONS.	
Patrick M Chism  PRINT NAME SIGNATURE	0695 MS LICENSE NUMBER 11-7-2018 DATE

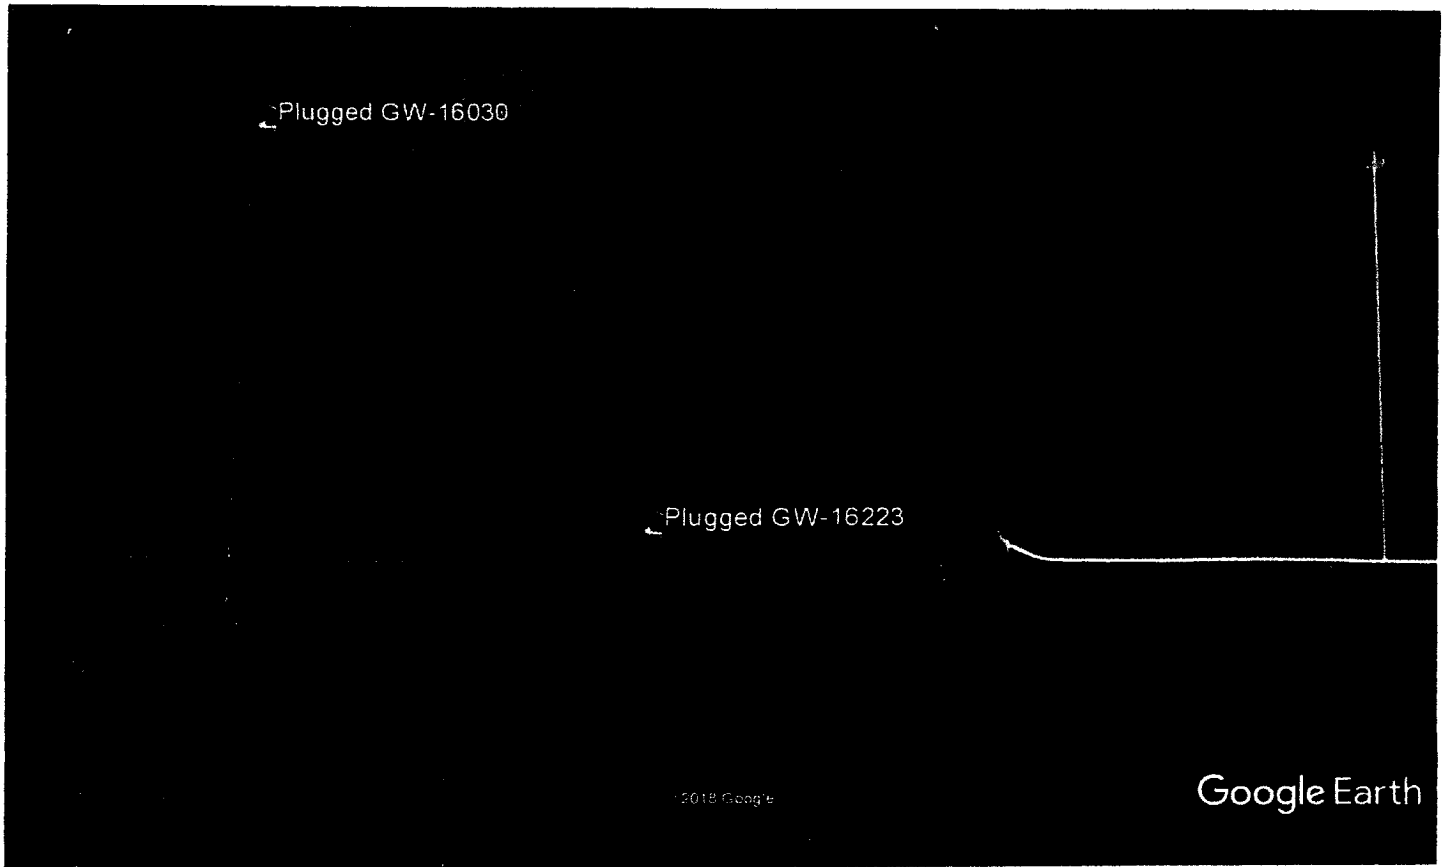

Google Earth



RECEIVED  
DEC 20 2018  
BY OLW