

WAMBA  
D19

3-68

MISSISSIPPI BOARD OF WATER COMMISSIONERS

CODED

CODED

CODED

### WATER WELL DRILLERS LOG

Date: 3/2, 1968, Driller: Harrison-Roman Well & Supply, Inc. County: Wamba  
(When well drilled) P. O. Box 42  
66 MILE 2ND ST HOOD. (Name)  
R.T. Post Poles & Gro. SHANNON, MISSISSIPPI 38688 (Where well is located)

(1) Owner of Land:	Description & Color of Materials Sand, Clay, Red Clay, Shell, etc.	Thick- ness Feet	Depth Feet
<u>EAST SMITH</u> (Name) <u>Box 1 Mauretta, Miss.</u> <u>N 1/2 SE NW</u> (Address)	<u>surface sand</u> <u>&amp; clay</u>	<u>0</u>	<u>30</u>
(2) Location: <u>NE 1/4, SW 1/4, Sec. 19 T8R8E</u> <u>4</u> miles <u>NW</u> , of <u>MAURETTA</u> (distance) (direction) (Nearest Town)	<u>Blue clay</u> <u>sand</u> <u>Bottom</u>	<u>30</u> <u>50</u> <u>(40)</u>	<u>50</u> <u>140</u>
(3) Topography: <u>Flat</u> (Hilly) (Flat) (Level)			
(4) Purpose of Well: <u>Home</u> (Domestic Irrigation Municipal, Industrial, Other)			

#### Information upon completion of well:

(1) Diameter 5 inches.

(2) Total Depth 140 feet.

(3) Water Level 35' feet below top of ground.

(4) Cased to 44' 4", Size 5

Screen: Size NONE, Length \_\_\_\_\_

CODED

Were any formations sealed against pollution?  
 yes, \_\_\_\_\_ no.

If YES depth of formation 30'


Why Surface & sand

Drillers Remarks: \_\_\_\_\_

Yield in gpm: 5

Size pump: 1/3

Type power: electric

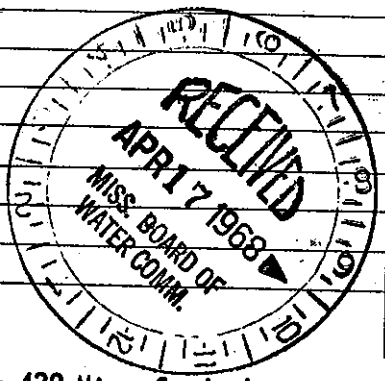

Mail this copy to Board of Water Commissioners 429 Miss. St. Jackson, Miss.