

STAWAMBA MISSISSIPPI BOARD OF WATER COMMISSIONERS
CODED

D22
9-19-63


WATER WELL D **CODED**

5M NO
Mantachie
371

Date: Sept 19, 1963, Driller: Ottis Webb, County Stawamba
(Name)

4 OLD STATE GR Trees Sch. Bus

(1) Owner of Land:	Description & Color of Materials Sand, Clay, Red Clay, Shell, etc.	Thick- ness Feet	Depth Feet
<u>Clayton Rushing</u> (Name) <u>Mantachie, Miss</u> (Address) 2824807			
(2) Location: <u>NE 1/4, NE 1/4, Sec. 23 T8R7E</u>			
<u>4</u> miles <u>NW</u> , of <u>Mantachie</u> (distance) (direction) (Nearest Town)			
(3) Topography: <u>Flat</u> (Hilly) (Flat) (Level)			
(4) Purpose of Well: <u>Domestic</u> (Domestic Irrigation Municipal, Industrial, Other)			

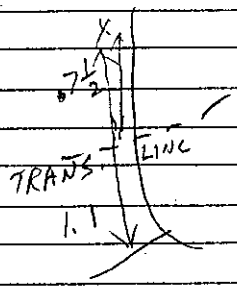


Information upon completion of well:

- (1) Diameter 4 inches.
- (2) Total Depth 114 feet.
- (3) Water Level 30 feet below top of ground.
- (4) Cased to 63, Size 4"
- (5) Screen: Size _____, Length _____.
- (6) Were any formations sealed against pollution?
_____ yes, _____ no.

CODED

If YES depth of formation _____
Why _____
Drillers Remarks: close to road

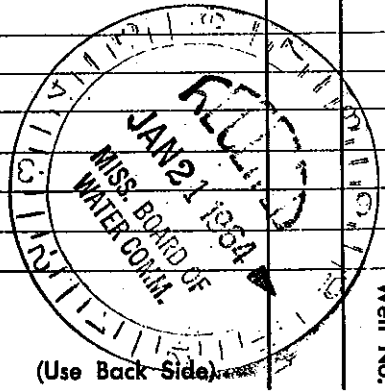

(Use Back Side)

Well No.

Mail this copy to Board of Water Commissioners 429 Miss. St. Jackson, Miss.