


G30  
7-65

**WATER WELL DRILLERS LOG**

Date: 7-14-, 1965, Driller: Layne-Central Co. County Itawamba  
(Name)

	Description & Color of Materials Sand, Clay, Red Clay, Shell, etc.	Thick- ness Feet	Depth Feet
(1) Owner of Land: <u>Mantachie Water Assn.</u> (Name) <u>Mantachie, Mississippi</u> (Address)	top soil	2	2
(2) Location: <u>1/4</u> , <u>1/4</u> , Sec. <u>T</u> <u>R</u> <u>      </u> miles <u>      </u> of <u>      </u> (distance) (direction) (Nearest Town)	clay sandy clay soapstone-clay	20 21 45	22 43 88
(3) Topography: <u>      </u> (Hilly) (Flat) (Level)	sandy clay draggy clayish sand	42 40	140 180
(4) Purpose of Well: <u>Municipal</u> (Domestic Irrigation Municipal, Industrial, Other)	clay sand soapstone-shale	15 10 58	195 205 263 <i>Kc</i>
Information upon completion of well:	rock	1	264
(1) Diameter <u>8</u> inches.	boulders	2	266
(2) Total Depth <u>343</u> feet.	soapstone & shale	31	297
(3) Water Level <u>86</u> feet below top of ground.	hard shale gravel	16 23	313 336
(4) Cased to <u>313'</u> , Size <u>8"</u>	rock	1	337
(5) Screen: Size <u>4"</u> , Length <u>30'</u>	clay	3	340
(6) Were any formations sealed against pollution? <u>X</u> yes, <u>      </u> no.	gravel	22	362
If YES depth of formation <u>313'</u>			
Why <u>      </u> required			
Drillers Remarks:			
<u>Elev 360 ?</u>			
<u>I 17</u>			

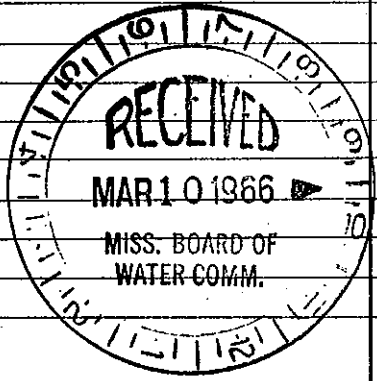

Well No.

(Use Back Side)