

MISSISSIPPI BOARD OF WATER COMMISSIONERS

ITAWAMBA CODED

G32  
10-7-60

WATER WELL DRILLERS LOG CODED

Date: Nov. 14, 1960, Driller: Ewing Gas Co. County: Itawamba  
(Name)

4 ON RT SIDE  $\frac{1}{2}$  PAST SCH

(1) Owner of Land:	Description & Color of Materials Sand, Clay, Red Clay, Shell, etc.	Thick- ness Feet	Depth Feet
<u>Mr. John M<sup>ST</sup> Ferris</u> (Name) <u>Mantachie, Miss.</u> (Address) 2825402 J.H. 2825516 J.M.			
(2) Location: <u>W<math>\frac{1}{2}</math> SW <math>\frac{1}{4}</math>, NE <math>\frac{1}{4}</math>, Sec. 5 T9<sup>S</sup> R8<sup>W</sup></u>			
_____ miles _____ of _____ (distance) (direction) (Nearest Town)			
(3) Topography: <u>Household</u> (Hilly) (Flat) (Level)			
(4) Purpose of Well: <u>Household</u> (Domestic Irrigation Municipal, Industrial, Other)			

Information upon completion of well:

- (1) Diameter 4 inches.
- (2) Total Depth 185 feet.
- (3) Water Level 70 feet below top of ground.
- (4) Cased to 62, Size \_\_\_\_\_
- (5) Screen: Size \_\_\_\_\_, Length \_\_\_\_\_
- (6) Were any formations sealed against pollution?  
 yes, \_\_\_\_\_ no.


If YES depth of formation 62'

Why \_\_\_\_\_

Drillers Remarks: \_\_\_\_\_

I 2

**CODED**

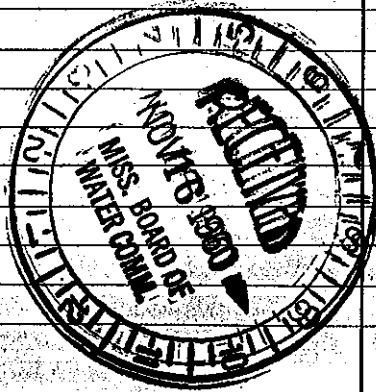

(Use Back Side)

Well No.