

TAWAMBA

MISSISSIPPI BOARD OF WATER COMMISSIONERS

633

CODED Case 5

CODED

WATER WELL DRILLERS LOG

HERNDON WELL & SUPPLY CO.

P.O. BOX 42

Date: June 16 1962, Driller: SHANNON, MISSISSIPPI County: Tawamba

Tishonice Cafe

(Name)

(1) Owner of Land:	Description & Color of Materials Sand, Clay, Red Clay, Shell, etc.	Thick- ness Feet	Depth Feet
JOE MIERS Mantachie, Miss. (Name) (Address)	Surface sand		0
(2) Location: N 1/2 SW SW 1/4, 1/4, Sec. 5 T9 R8 E	2 clay		18
in miles of Mantachie (distance) (direction) (Nearest Town)	Blue shale		
(3) Topography: Hilly (Hilly) (Flat) (Level)	Sand		25
(4) Purpose of Well: Handy Not (Domestic Irrigation Municipal, Industrial, Other)			
	Bottom 100		


Information upon completion of well:

- (1) Diameter 6 inches. NOT IN USE
- (2) Total Depth 100 feet. 4-12-72 STILL FLOWS
- (3) Water Level Flows feet below top of ground.
- (4) Cased to 38', Size 6"
- (5) Screen: Size _____, Length _____
- (6) Were any formations sealed against pollution?
 yes, no.

If YES depth of formation 38 ft

Why: ~~gravel~~ sand

Drillers Remarks: Well flows
Appx 100 GPH

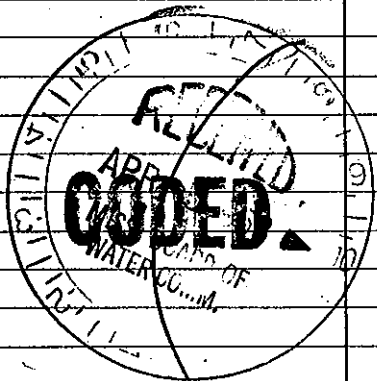

(Use Back Side)

Well No.