

ITAWAMBA COUNTY MISSISSIPPI BOARD OF WATER COMMISSIONERS

637  
3-8-63

CODED

WATER WELL DRILLERS LOG

CODED

HERNDON WELL & SUPPLY CO.

Date: March 8, 1963, Driller: HERNDON WELL & SUPPLY CO. P. O. BOX 42, County Itawamba  
4 SHANNON, MISSISSIPPI

Contractor: James Smith  
(1) Owner of Land: James Smith  
(Name)

# 3 Rt 1 Doyley Miso  
2823715 (Address)  
SE NE NE  
(2) Location: 1/4, 1/4, Sec. 9 1/4 TR

2 1/2 miles SW of Montachita  
(distance) (direction) (Nearest Town)

(3) Topography: Flat  
(Hilly) (Flat) (Level)

(4) Purpose of Well: Domestic  
(Domestic Irrigation, Municipal, Industrial, Other)

Description & Color of Materials Sand, Clay, Red Clay, Shell, etc.	Thick- ness Feet	Depth Feet
<u>surface sand</u>		0
<u>clay</u>		
<u>Blue rock</u>		36
<u>sand</u>		80
<u>Bottom</u>		180

Information upon completion of well:

(1) Diameter 4 inches.

(2) Total Depth 180 feet.

(3) Water Level 30 feet below top of ground.

(4) Cased to 4 1/2", Size 4"

(5) Screen: Size \_\_\_\_\_, Length \_\_\_\_\_

(6) Were any formations sealed against pollution?


yes,  no.

If YES depth of formation 36 ft.

Why surface sand

Drillers Remarks:

CODED

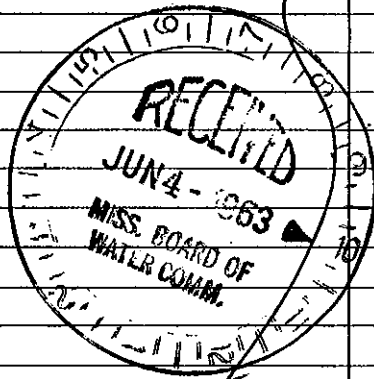

17

(Use Back Side)

Well No.

Mail this copy to Board of Water Commissioners 429 Miss. St. Jackson, Miss