

ITAWAMBA MISSISSIPPI BOARD OF WATER COMMISSIONERS

CODED

CODED

G38
3-8-63

WATER WELL DRILLERS LOG

HERNDON WELL & SUPPLY CO.

Date: March 4, 1963 Driller: SHANNON P.O. BOX 42
4 (Name) MISSISSIPPI County Itawamba

(1) Owner of Land: James Smith
(Name)

#1 At 1 Dacey, Miss
(Address)
SE NE NE

(2) Location: 30 1/4, 05 1/4, Sec. 16 T. 95 R. 16
2 1/2 miles SW, of Mantachie
(distance) (direction) (Nearest Town)

(3) Topography: Flat
(Hilly) (Flat) (Level)

(4) Purpose of Well: Domestic
(Domestic Irrigation
Municipal, Industrial, Other)

Description & Color of Materials Sand, Clay, Red Clay, Shell, etc.	Thick- ness Feet	Depth Feet
<u>surface sand</u>		<u>0</u>
<u>& clay</u>		
<u>Blue sand</u>		<u>30</u>
<u>&</u>		
<u>hard</u>		<u>60</u>
<u>&</u>		
<u>Bottom</u>		<u>180</u>

Information upon completion of well:

(1) Diameter 4 inches.

(2) Total Depth 180 feet.

(3) Water Level 30 feet below top of ground.

(4) Cased to 42 ft, Size 4 in.

(5) Screen: Size _____, Length _____.


(6) Were any formations sealed against pollution?
yes, _____ no.

If YES depth of formation 30 ft.

Why surface & sand

Drillers Remarks: _____

CODED

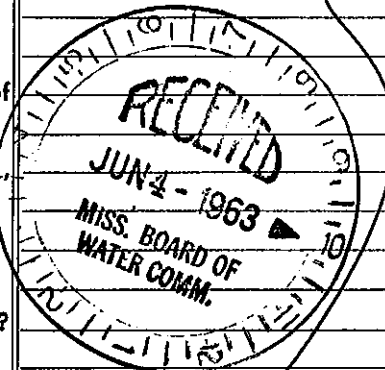

I 10

(Use Back Side)

Well No. 1

Mail this copy to Board of Water Commissioners 429 Miss. St. Jackson, Miss.