

ITAWAMBA MISSISSIPPI BOARD OF WATER COMMISSIONERS

639  
3-8-63

CODED

WATER WELL DRILLERS LOG

CODED

HERNDON WELL & SUPPLY CO.

Date March 7, 1963, Driller: SHANNON P.O. BOX 42 County Itawamba  
4 (Name) MISSISSIPPI

	Description & Color of Materials Sand, Clay, Red Clay, Shell, etc.	Thick- ness Feet	Depth Feet
(1) Owner of Land: <u>James Smith</u> (Name)			
<u>M. Dorsey</u> (Address)	<u>surface sand &amp; clay</u>		0
(2) Location: <u>SW 1/4, SE 1/4, Sec. 16 T. 95 N. R. 14 E.</u>	<u>Blue rock</u>		36
<u>2 1/2</u> miles <u>SW</u> of <u>Marshall</u> (distance) (direction) (Nearest Town)	<u>Sand</u>		65
(3) Topography: <u>Flat</u> (Hilly) (Flat) (Level)	<u>Bottom</u>		180
(4) Purpose of Well: <u>Domestic</u> (Domestic Irrigation Municipal, Industrial, Other)			

Information upon completion of well:


- (1) Diameter 4 inches.
- (2) Total Depth 180 feet.
- (3) Water Level 30 feet below top of ground.
- (4) Cased to 42', Size 4".
- (5) Screen: Size \_\_\_\_\_, Length \_\_\_\_\_.
- (6) Were any formations sealed against pollution?  
yes, \_\_\_\_\_ no.

If YES depth of formation 30 ft.

Why surface & sand

Drillers Remarks:

CODED

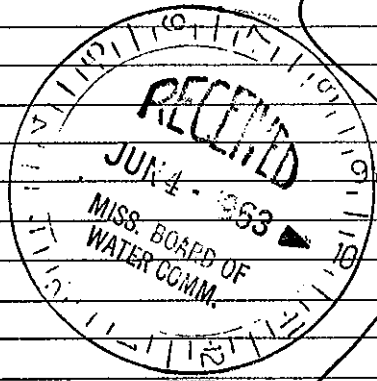

(Use Back Side)

Well No. 2

Mail this copy to Board of Water Commissioners 429 Miss. St. Jackson, Miss